

MAR 15 2000

SECTION

CLERK REGISTER
ST. CLAIR COUNTY
RECEIVED FOR RECORD

DEC 22 1999

LIBER PAGE TIME
Marilyn Dunn
MARILYN DUNN

Register of Deeds Stamp & File Number



ST. CLAIR COUNTY, MICHIGAN
OFFICIAL GOVERNMENT CORNER

LAND CORNER RECORDATION CERTIFICATE
Filing Requirement of Act 74, Mich. P.A. 1970

Located In: Corner Code #
CASCO TOWNSHIP E-1

- 1. Public Land Survey T 4N R 15E E-1
- 2. Property Controlling in Section S _____ T _____ R _____
- 3. Miscellaneous S _____ T _____ R _____
- Property in Sec. S _____ T _____ R _____
- 4. Lot No. _____, Recorded Plat _____
- 5. Private Claims _____

I, MICHAEL J ROSSOW, in a field survey on AUGUST 27, 1999, do hereby certify that under requirements of P.A. 74, Michigan P.A. of 1970, the corner points mentioned in lines 1 and 2 above were in conformance with regulations and rules therefore as required in the current manual of survey instructions of the United States Department of the Interior, Bureau of Land Management or by a decree of a Court of Law and/or that the corner points mentioned in lines 3, 4 and 5 above were in conformance with the rules of the Michigan Board of Land Surveyors or by a Decree of a Court of Law; established, re-established, monumented, re-monumented, recovered, found as expressed below:

| | A | B | C | D | E | F | G | H | I | J | K | L | M |
|----|----|----|----|----|----|----|---|---|---|---|---|---|---|
| 2 | 6 | 5 | 4 | 3 | 2 | 1 | | | | | | | |
| 3 | | | | | | | | | | | | | |
| 4 | 7 | 8 | 9 | 10 | 11 | 12 | | | | | | | |
| 5 | | | | | | | | | | | | | |
| 6 | 18 | 17 | 16 | 15 | 14 | 13 | | | | | | | |
| 7 | | | | | | | | | | | | | |
| 8 | 19 | 20 | 21 | 22 | 23 | 24 | | | | | | | |
| 9 | | | | | | | | | | | | | |
| 10 | 30 | 29 | 28 | 27 | 26 | 25 | | | | | | | |
| 11 | | | | | | | | | | | | | |
| 12 | 31 | 32 | 33 | 34 | 35 | 36 | | | | | | | |
| 13 | | | | | | | | | | | | | |

NOTE: Not more than 1 CORNER, may be recorded on this certificate.

A. Description of original monument and accessories and/or subsequent restoration:

- E-1, CASCO TOWNSHIP, 1817, W. PRESTON (SET A POST FOR THIS CLOSING CORNER 30 LINKS EAST OF THE SOUTHEAST CORNER OF SECTION 32, T.5N., R.15E.)
- (A) 1973, H. KOB'S LCRC L.1, P.735 (FOUND A 1/2" IRON BAR & WITNESSED)
- (B) 1974, C. ALLOWAY LCRC L.2, P.289 (FOUND AN IRON REROD & WITNESSED THE SAME)
- (C) 1986, H. KOB'S LCRC L.5, P.322 (FOUND A BOLT & WASHER IN PAVEMENT & WITNESSED)
- (D) 1990, D. LITTLE LCRC L.6, P.324 (FOUND A BOLT & WASHER IN PAVEMENT & WITNESSED)
- (E) 1974, J. LANSKY LCRC L.2, P.9-10 (FINDS A 1/2" REROD & WITNESSES)
- (F) 1942, OLD COUNTY SURVEYORS RECORD (FINDS A LARGE PLAT STONE & WITNESSES)
- (G) 1974, J. LANSKY SURVEY L.2, P.822 (FOUND & USED IRON, NO WITNESSES, REFERS TO RECORDED CERTIFICATE FILED)

*SEE BACK OF SHEET

B. Description of corner evidence found and/or method applied in restoring or reestablishing corner:


E-1, FOUND A MONUMENT BOX WITH A RAILROAD SPIKE INSIDE, USING DATA FROM PART "A" ABOVE (SURVEYS & LCRC) AND NOTED THE FOLLOWING:
50.0' NORTH EAST TO PK IN WEST SIDE OF DETROIT EDISON POLE (D)(K)(L)(R)
95.2' NORTH WEST TO PK IN NORTH EAST SIDE OF DETROIT EDISON POLE (D)(Z)(K)(L)(M)(R)(S)
56.2' SOUTH EAST TO SPIKE IN WEST SIDE OF 18" MAPLE (D)(C)(K)(L)(M)(Q)(S)
59.8' SOUTH WEST TO NAIL IN POWER POLE (C)(D)(K)(M)(R)(S)
75.4' NORTH WEST TO NAIL IN TELEPHONE POLE (C)(K)(L)(Q)(S)
36.5' WEST TO SOUTH EAST CORNER OF SECTION 32, T.5N., R.15E. (E)(M)

PA 345-1990
PEER COMMITTEE
APPROVED 12-15-99

C. Description of monument for corner and accessories established to perpetuate locating the position of the corner:

SET A 2" DIAMETER ALUMINUM CAP WITH MAGNET ATTACHED & INSCRIBED "ST. CLAIR COUNTY OFFICIAL CORNER" ON THE EXISTING RAILROAD SPIKE IN MONUMENT BOX AT THE CLOSING CORNER WHICH LIES 0.11' SOUTH OF AND NORMAL TO A LINE BETWEEN THE SOUTH WEST CORNER OF SECTION 33 AND THE SOUTH 1/4 CORNER OF SECTION 33, T5N., R.15E., AND WITNESSED AS FOLLOWS:
SOUTH EAST 39.7' TO COUNTY TAG IN GAS LINE MARKER
SOUTH WEST 60.1' TO COUNTY TAG IN POWER POLE
NORTH WEST 75.4' TO COUNTY TAG IN POWER POLE
NORTH EAST 79.91' TO COUNTY TAG IN POWER POLE

THE SELECTED LOCATION IS ACCEPTED BY ME AND IS GENERALLY ACCEPTED BY PROFESSIONAL SURVEYORS AS THE BEST AVAILABLE EVIDENCE OF THE POSITION OF THE ORIGINAL CORNER.

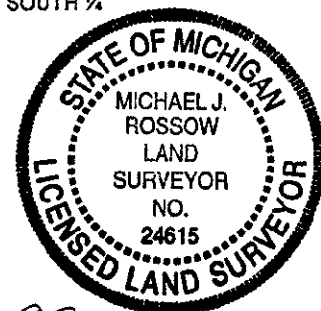

Signed by _____
Surveyor's Michigan License No. 24615

Date 12-17-99



ST. CLAIR COUNTY, MICHIGAN
OFFICIAL GOVERNMENT CORNER

SURVEY &
REMONUMENTATION

MAR 15 2000

SECTION

LAND CORNER RECORDATION CERTIFICATE
Filing Requirement of Act 74, Mich. P.A. 1970

| | Located In: | Corner Code # |
|---------------------------------------|--------------------------|---------------|
| | CASCO TOWNSHIP | |
| 1. Public Land Survey | T <u>4N</u> R <u>15E</u> | <u>E-1</u> |
| | T _____ R _____ | _____ |
| 2. Property Controlling in Section | S _____ T _____ R _____ | _____ |
| | S _____ T _____ R _____ | _____ |
| 3. Miscellaneous Property in Sec. | S _____ T _____ R _____ | _____ |
| | S _____ T _____ R _____ | _____ |

Register of Deeds Stamp & File Number

- (H) 1973, H. KOBBS SURVEY L.2, P.108 (FINDS AND WITNESSES AN IRON BAR)
- (I) 1974, H. KOBBS SURVEY L.2, P.710 (FINDS AND WITNESSES AN IRON BAR)
- (J) 1989, H. KOBBS SURVEY L.10, P.314 (FINDS & WITNESSES A "BOLT & WASHER" IN PAVEMENT)
- (K) 1989 C. McDANIEL SURVEY L.11, P.66 (FINDS & WITNESSES A "BOLT & WASHER" IN PAVEMENT)
- (L) 1989, G. JAMES SURVEY L.11, P.107 (FINDS & WITNESSES A "BOLT" IN PAVEMENT)
- (M) 1970, VTA UNRECORDED SURVEY (REFERS TO "FOUND IRON", NO WITNESSES RECITED)
- (N) NO DATE, VTA UNRECORDED SURVEY (REFERS TO "FOUND IRON", NO WITNESSES RECITED)
- (O) 1979, FENN UNRECORDED SURVEY (REFERS TO CORNER POST FOUND AND RECORDED BY OTHERS)
- (P) 1991, G. JAMES UNRECORDED SURVEY (REFERS TO "BOLT" AS CORNER & WITNESSES)
- (Q) 07-07-93, R. KREGER, ST. CLAIR COUNTY ROAD COMMISSION PLANS (INSTALLED MONUMENT BOX & WITNESSED)
- (R) 1992, R. KREGER, ST. CLAIR COUNTY ROAD COMMISSION WITNESS BOOK