



ST. CLAIR COUNTY, MICHIGAN  
OFFICIAL GOVERNMENT CORNER

SURVEY &  
REMONUMENTATION

MAR 15 2000

LAND CORNER RECORDATION CERTIFICATE  
Filing Requirement of Act 74, Mich. P.A. 1970

SECTION

CLERK REGISTER  
ST. CLAIR COUNTY  
RECEIVED FOR RECORD

DEC 22 1999

LIBER PAGE TIME 8:00 AM  
*Marilyn Dunn*  
MARILYN DUNN

Register of Deeds Stamp & File Number

	Located In:	Corner Code #
	CASCO TOWNSHIP	
1. Public Land Survey	T <u>4N</u> R <u>15E</u>	<u>I-1</u>
	T _____ R _____	_____
2. Property Controlling in Section	S _____ T _____ R _____	_____
	S _____ T _____ R _____	_____
3. Miscellaneous Property in Sec.	S _____ T _____ R _____	_____
	S _____ T _____ R _____	_____
4. Lot No. _____, Recorded Plat _____		
5. Private Claims _____		

I, MICHAEL J. ROSSOW, in a field survey on AUGUST 4, 1999, do hereby certify that under requirements of P.A. 74, Michigan P.A. of 1970, the corner points mentioned in lines 1 and 2 above were in conformance with regulations and rules therefore as required in the current manual of survey instructions of the United States Department of the Interior, Bureau of Land Management or by a decree of a Court of Law and/or that the corner points mentioned in lines 3, 4 and 5 above were in conformance with the rules of the Michigan Board of Land Surveyors or by a Decree of a Court of Law; established, re-established, monumented, re-monumented, recovered, found as expressed below:

	A	B	C	D	E	F	G	H	I	J	K	L	M
2	6	5	4	3	2	1							
3													
4	7	8	9	10	11	12							
5													
6	18	17	16	15	14	13							
7													
8	19	20	21	22	23	24							
9													
10	30	29	28	27	26	25							
11													
12	31	32	33	34	35	36							
13													

NOTE: Not more than 1 CORNER, may be recorded on this certificate.

A. Description of original monument and accessories and/or subsequent restoration:

- I-1 CASCO TOWNSHIP, 1817, W. PRESTON OF GLO (SET A CLOSING CORNER POST 1.54 LINKS EAST (101.64') OF SE CORNER OF SECTION 34, T.5N, R.15E.)
- (A) 1974, B. COLLINS LCRC L.3, P.308 (FOUND AN "IRON PIPE & APPLIED WITNESSES)
- (B) 1980, R. KREGER LCRC L.5, P.124 (FOUND PK & TAG IN PAVEMENT & APPLIED WITNESSES)
- (C) 1980, R. KREGER LCRC L.7, P.345 (FOUND PK & TAG AND WITNESSED THE SAME)
- (D) 1974, B. COLLINS SURVEY L.3, P.287 (REFERS TO CORNER, DOES NOT ID BUT APPLIES WITNESSES TO OBJECT)
- (E) ST. CLAIR COUNTY ROAD COMMISSION PLAN 07-07-93 (WITNESSES & SETS MONUMENT BOX)
- (F) OLD COUNTY SURVEYORS RECORD 1942± SHOWS NO CORNER)
- (G) ST. CLAIR COUNTY ROAD COMMISSION WITNESS BOOK (03-12-81)
- (H) UNDATED SURVEY BY R. KREGER (REFERENCES CORNER BUT NO ID OR WITNESSES)

B. Description of corner evidence found and/or method applied in restoring or reestablishing corner:


FOUND A "T" IRON IN A STD. MONUMENT BOX IN THE ASPHALT PAVEMENT USING & VERIFYING LCRC CERTS. & SURVEYS ABOVE IN PART "A" AND VERIFYING WITNESSES AS FOLLOWS:  
WEST 108.1' TO SOUTHEAST CORNER OF SECTION 34, T.5N, R.15E. (B)(E)(G)  
NORTH NORTH EAST 55.5' SPIKE & TAG IN DETROIT EDISON POLE (E)(G)(C)  
SOUTH SOUTH EAST 38.9' TO STOP SIGN (E)  
NORTH 50.0' TO PROPERTY CORNER (E)  
NORTH EAST 55.5' TO TAG IN DETROIT EDISON POLE (B)

PA 345-1990  
P&T COMMITTEE  
APPROVED 12-15-99

C. Description of monument for corner and accessories established to perpetuate locating the position of the corner:

SET A 2" DIAMETER ALUMINUM CAP WITH MAGNET ATTACHED & INSCRIBED "ST. CLAIR COUNTY OFFICIAL CORNER, REMOVED "T" IRON AND SET 1/2" REROD IN MONUMENT BOX AT THE CLOSING CORNER WHICH LIES 0.16' NORTH OF AND NORMAL TO A LINE BETWEEN THE SOUTH WEST CORNER OF SECTION 35 AND THE SOUTH 1/4 CORNER OF SECTION 35, T.5N., R.15E. & WITNESSED AS FOLLOWS:  
NORTH EAST 54.94' TO COUNTY TAG IN POWER POLE  
SOUTH EAST 27.32' TO COUNTY TAG IN POWER POLE  
SOUTH WEST 99.21' TO COUNTY TAG IN 8" TREE  
WEST SOUTH WEST 384.37' TO COUNTY TAG IN POWER POLE

THE SELECTED LOCATION IS ACCEPTED BY ME AND IS GENERALLY ACCEPTED BY PROFESSIONAL SURVEYORS AS THE BEST AVAILABLE EVIDENCE OF THE POSITION OF THE ORIGINAL CORNER.

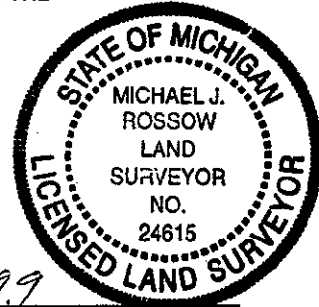

Signed by *[Signature]*  
Surveyor's Michigan License No. 24615

Date 12-17-99