



ST. CLAIR COUNTY, MICHIGAN
OFFICIAL GOVERNMENT CORNER

SURVEY &
REMONUMENTATION

MAR 15 2000

SECTION

LAND CORNER RECORDATION CERTIFICATE
Filing Requirement of Act 74, Mich. P.A. 1970

CLERK REGISTER
ST. CLAIR COUNTY
RECEIVED FOR RECORD

DEC 22 1999

8:00 AM

LIBER PAGE TIME
Marilyn Dunn
MARILYN DUNN

Register of Deeds Stamp & File Number

	Located In:	Corner Code #
	CASCO TOWNSHIP	
1. Public Land Survey	T 4N R 15E	J-1
	T _____ R _____	_____
2. Property Controlling in Section	S _____ T _____ R _____	_____
	S _____ T _____ R _____	_____
3. Miscellaneous Property in Sec.	S _____ T _____ R _____	_____
	S _____ T _____ R _____	_____
4. Lot No. _____, Recorded Plat _____		
5. Private Claims _____		

	A	B	C	D	E	F	G	H	I	J	K	L	M
2	6	5	4	3	2	1							
3													
4	7	8	9	10	11	12							
5													
6	18	17	16	15	14	13							
7													
8	19	20	21	22	23	24							
9													
10	30	29	28	27	26	25							
11													
12	31	32	33	34	35	36							
13													

I, MICHAEL J. ROSSOW, in a field survey on AUGUST 27, 1999, do hereby certify that under requirements of P.A. 74, Michigan P.A. of 1970, the corner points mentioned in lines 1 and 2 above were in conformance with regulations and rules therefore as required in the current manual of survey instructions of the United States Department of the Interior, Bureau of Land Management or by a decree of a Court of Law and/or that the corner points mentioned in lines 3, 4 and 5 above were in conformance with the rules of the Michigan Board of Land Surveyors or by a Decree of a Court of Law; established, re-established, monumented, re-monumented, recovered, found as expressed below:

NOTE: Not more than 1 CORNER, may be recorded on this certificate.

A. Description of original monument and accessories and/or subsequent restoration:

- J-1, NO CORNER SET DURING ORIGINAL GOVERNMENT SURVEY OF 1817
- (A) 1986, R. KREGER LCRC L.5, P.318 (SETS CORNER FOR ROAD RECONSTRUCTION USING "SURVEY BY OTHER & WITNESSES)
- (B) OLD ST. CLAIR COUNTY SURVEYOR'S RECORD (1942) SHOWS NO CORNER
- (C) 08-28-1989, L. THOMAS UNRECORDED SURVEY (REFERS & MEASURES TO CORNER FROM NORTH EAST CORNER OF SECTION 2, NO WITNESSES GIVEN)
- (D) UNDATED SURVEY BY R. KREGER (REFERS & MEASURES TO CORNER FROM NORTH EAST CORNER OF SECTION 2, WITH WITNESSES)

B. Description of corner evidence found and/or method applied in restoring or reestablishing corner:


FOUND 1/2" REROD IN STD. MONUMENT BOX IN WEST BOUND LANE OF HIGHWAY USING & VERIFYING SOME LCRC & ACT 132 SURVEYS ABOVE IN PART "A" & VERIFIED THE FOLLOWING LOCAL WITNESSES:
38.25' WEST TO SOUTH 1/4 CORNER OF SECTION 35, COLUMBUS TOWNSHIP, T.5N., R.15E. (A)
190.2' EAST SOUTH EAST TO SOUTH WEST CORNER BRIDGE DECK (A)(E)
132.7' WEST NORTH WEST TO SPIKE IN DETROIT EDISON POLE (A)(E)
59.2' SOUTH TO SPIKE IN FENCE POST (A)

PA 345-1990
PEER COMMITTEE
APPROVED 12-15-99

C. Description of monument for corner and accessories established to perpetuate locating the position of the corner:

SET A 2" DIAMETER ALUMINUM CAP WITH MAGNET ATTACHED & INSCRIBED "ST. CLAIR COUNTY OFFICIAL CORNER" ON THE EXISTING 1/2" REROD IN MONUMENT BOX AT THE CLOSING CORNER WHICH LIES 0.14' NORTH OF AND NORMAL TO A LINE BETWEEN THE SOUTH 1/4 CORNER OF SECTION 35 & THE SOUTH EAST CORNER OF SECTION 35, T.5N, R.15E. & WITNESSES AS FOLLOWS:
SOUTH EAST 50.07' TO COUNTY TAG IN GUARD RAIL
NORTH EAST 46.35' TO COUNTY TAG IN GUARD RAIL
WEST NORTH WEST 132.64' TO COUNTY TAG IN POWER POLE
WEST SOUTH WEST 213.77' TO COUNTY TAG IN 10' TREE

THE SELECTED LOCATION IS ACCEPTED BY ME AND IS GENERALLY ACCEPTED BY PROFESSIONAL SURVEYORS AS THE BEST AVAILABLE EVIDENCE OF THE POSITION OF THE ORIGINAL CORNER.

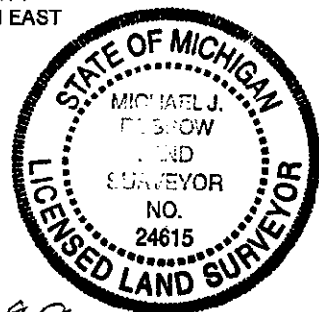

Signed by *[Signature]* Date 12-17-99
Surveyor's Michigan License No. 24615