

MAR 15 2000

SECTION



ST. CLAIR COUNTY, MICHIGAN
OFFICIAL GOVERNMENT CORNER

LAND CORNER RECORDATION CERTIFICATE
Filing Requirement of Act 74, Mich. P.A. 1970

CLERK REGISTER
ST. CLAIR COUNTY
RECEIVED FOR RECORD

DEC 22 1999 8:00 am

LIBER PAGE TIME
Maureen Quinn
MARIE YVON QUINN

Register of Deeds Stamp & File Number

| | | |
|---------------------------------------|--------------------------|---------------|
| | Located In: | Corner Code # |
| | CASCO TOWNSHIP | |
| 1. Public Land Survey | T <u>4N</u> R <u>15E</u> | <u>K-1</u> |
| | T _____ R _____ | _____ |
| 2. Property Controlling in Section | S _____ T _____ R _____ | _____ |
| | S _____ T _____ R _____ | _____ |
| 3. Miscellaneous Property in Sec. | S _____ T _____ R _____ | _____ |
| | S _____ T _____ R _____ | _____ |
| 4. Lot No. _____, Recorded Plat _____ | | |
| 5. Private Claims _____ | | |

| | | | | | | | | | | | | | |
|----|----|----|----|----|----|----|---|---|---|---|---|---|---|
| | A | B | C | D | E | F | G | H | I | J | K | L | M |
| 2 | 6 | 5 | 4 | 3 | 2 | 1 | | | | | | | |
| 3 | | | | | | | | | | | | | |
| 4 | 7 | 8 | 9 | 10 | 11 | 12 | | | | | | | |
| 5 | | | | | | | | | | | | | |
| 6 | 18 | 17 | 16 | 15 | 14 | 13 | | | | | | | |
| 7 | | | | | | | | | | | | | |
| 8 | 19 | 20 | 21 | 22 | 23 | 24 | | | | | | | |
| 9 | | | | | | | | | | | | | |
| 10 | 30 | 29 | 28 | 27 | 26 | 25 | | | | | | | |
| 11 | | | | | | | | | | | | | |
| 12 | 31 | 32 | 33 | 34 | 35 | 36 | | | | | | | |
| 13 | | | | | | | | | | | | | |

I, MICHAEL J. ROSSOW, in a field survey on JULY 21, 1999, do hereby certify that under requirements of P.A. 74, Michigan P.A. of 1970, the corner points mentioned in lines 1 and 2 above were in conformance with regulations and rules therefore as required in the current manual of survey instructions of the United States Department of the Interior, Bureau of Land Management or by a decree of a Court of Law and/or that the corner points mentioned in lines 3, 4 and 5 above were in conformance with the rules of the Michigan Board of Land Surveyors or by a Decree of a Court of Law; established, re-established, monumented, re-monumented, recovered, found as expressed below:

NOTE: Not more than 1 CORNER, may be recorded on this certificate.

A. Description of original monument and accessories and/or subsequent restoration:

- K-1 1817, CASCO TOWNSHIP, W. PRESTON OF GLO (SET A CLOSING CORNER 30 LINKS (19.8') EAST OF THE SOUTH WEST CORNER OF SECTION 36, T.5N, R.15E.)
 - (A) 1974, C. ALLOWAY LCRC L.3, P.106 (FINDS & WITNESSES AN "IRON ROD" UNDER THE ASPHALT)
 - (B) 1975, J. LANSKY SURVEY L.3, P. 243 (REFERS TO CORNER DOES NOT ID OR WITNESS IT)
 - (C) 1975, J. LANSKY SURVEY L.4, P.21 (REFERS TO CORNER DOES NOT ID OR WITNESS IT)
 - (D) 1979, R. KREGER SURVEY L.7, P.172 (FINDS & WITNESSES A 1" PIPE IN MONUMENT BOX)
 - (E) 1983, R. KREGER SURVEY L.7, P.221 (FINDS & WITNESSES A 1" PIPE IN MONUMENT BOX)
 - (F) 1942, OLD ST. CLAIR COUNTY SURVEYORS RECORD (IDENTIFIES & WITNESSES AN IRON ROD FOR THIS CORNER)
- *SEE BACK OF SHEET


B. Description of corner evidence found and/or method applied in restoring or reestablishing corner:

- K-1 FOUND A STD MONUMENT BOX WITH A 1/2" IRON ROD AT THIS CORNER USING DISTANCES AND DATA FROM "A" ABOVE AND VERIFIED THE FOLLOWING WITNESSES:
- 67.2' SOUTH WEST NAIL IN 8" ELM TREE (G)
- 97.3' SOUTH WEST TO PK (SE) IN GUT POLE (E)
- 77.75' NORTH WEST TO PK (SW) IN DETROIT EDISON POLE (E)(D)
- 18.1' WEST TO CORNER COMMON TO SECTION 35 & 36 COLUMBUS T.5N, R.15E. (A)(F)(G)(D)
- ON CENTER OF PAVEMENT EAST & WEST (E)(F)

PA 345-1990
PEER COMMITTEE
APPROVED 12-15-99

C. Description of monument for corner and accessories established to perpetuate locating the position of the corner:

- SET A 2" DIAMETER ALUMINUM CAP WITH MAGNET ATTACHED & INSCRIBED "ST. CLAIR COUNTY OFFICIAL CORNER" ON THE EXISTING 1/2" IRON IN MONUMENT BOX AT THE CLOSING CORNER WHICH LIES ON A LINE BETWEEN THE SOUTH WEST CORNER OF SECTION 36 & THE SOUTH 1/4 CORNER OF SECTION 36, T.5N, R.15E. & WITNESSES AS FOLLOWS:
- EAST NORTH EAST 151.11' TO COUNTY TAG IN POWER POLE
- EAST SOUTH EAST 153.32 TO COUNTY TAG IN POWER POLE
- SOUTH WEST 97.33' TO COUNTY TAG IN GUY POLE
- NORTH WEST 77.45' TO COUNTY TAG IN POWER POLE

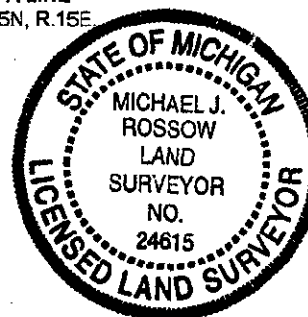

THE SELECTED LOCATION IS ACCEPTED BY ME AND IS GENERALLY ACCEPTED BY PROFESSIONAL SURVEYORS AS THE BEST AVAILABLE EVIDENCE OF THE POSITION OF THE ORIGINAL CORNER.

Signed by _____

Date 12-17-99

Surveyor's Michigan License No. 24615



ST. CLAIR COUNTY, MICHIGAN
OFFICIAL GOVERNMENT CORNER

SURVEY &
REMONUMENTATION

LAND CORNER RECORDATION CERTIFICATE
Filing Requirement of Act 74, Mich. P.A. 1970

MAR 15 2000

| | Located In: | Corner Code # |
|------------------------------------|--------------------------|---------------|
| | CASCO TOWNSHIP | |
| 1. Public Land Survey | T <u>4N</u> R <u>15E</u> | <u>-K-1</u> |
| | T _____ R _____ | _____ |
| 2. Property Controlling in Section | S _____ T _____ R _____ | _____ |
| | S _____ T _____ R _____ | _____ |
| 3. Miscellaneous Property in Sec. | S _____ T _____ R _____ | _____ |
| | S _____ T _____ R _____ | _____ |

SECTION

Register of Deeds Stamp & File Number

- (G) ST. CLAIR COUNTY ROAD COMMISSION CONSTRUCTION PLANS 07-07-1993 (SETS MONUMENT BOX OVER POINT & WITNESSES)
- (H) ST. CLAIR COUNTY ROAD COMMISSION SECTION CORNER WITNESS BOOK (1960)
- (I) MDOT RIGHT OF WAY FOR I-94 (1962)