

MAR 15 2000

SECTION



ST. CLAIR COUNTY, MICHIGAN OFFICIAL GOVERNMENT CORNER

LAND CORNER RECORDATION CERTIFICATE Filing Requirement of Act 74, Mich. P.A. 1970

CLERK REGISTER ST. CLAIR COUNTY RECEIVED FOR RECORD

DEC 22 1999 8:00 AM LIBER PAGE TIME [Signature]

Register of Deeds Stamp & File Number

1. Public Land Survey Located In: COLUMBUS TOWNSHIP Corner Code # E-13
2. Property Controlling in Section S T R
3. Miscellaneous Property in Sec. S T R
4. Lot No. Recorded Plat
5. Private Claims

I, MICHAEL J. ROSSOW, In a field survey on AUGUST 26, 1999, do hereby certify that under requirements of P.A. 74, Michigan P.A. of 1970, the corner points mentioned in lines 1 and 2 above were in conformance with regulations and rules therefore as required in the current manual of survey instructions of the United States Department of the Interior, Bureau of Land Management or by a decree of a Court of Law and/or that the corner points mentioned in lines 3, 4 and 5 above were in conformance with the rules of the Michigan Board of Land Surveyors or by a Decree of a Court of Law; established, re-established, monumented, re-monumented, recovered, found as expressed below:

Grid table with columns A-M and rows 2-13. A dot is marked in the cell at row 12, column G.

NOTE: Not more than 1 CORNER, may be recorded on this certificate.

A. Description of original monument and accessories and/or subsequent restoration:

- E-13, COLUMBUS TOWNSHIP, 1817, W. PRESTON OF GLO (MADE CORNER ON A 2 1/2" BLACK CHERRY TREE)
(A) 1974, J. LANSKY LCRC L.2, P.9 (FOUND 1/2" REROD, NO WITNESSES, BUT REFERENCES CLOSING CORNERS)
(B) 1974, C. ALLOWAY LCRC L.2, P.288 (FOUND 1/2" IRON REROD & WITNESSED)
(C) 1975, H. KOBS LCRC L.3, P.203 (FOUND 1" X1" IRON BAR & WITNESSED & RAISED TO SURFACE WITH A 3/8" BAR.
(D) 1977, B. COLLINS LCRC L.4, P.279 (FOUND "CAP BOLT" & WITNESSED)
(E) 1942, OLD SURVEYOR RECORDS (WITNESSES A CORNER BUT DOES NOT IDENTIFY IT)
(F) 1995, C. ALLOWAY SURVEY L.1442, P.97 (REFERS TO A MONUMENT IN CENTER OF ROAD WITH NO WITNESSES)
*SEE BACK OF SHEET

B. Description of corner evidence found and/or method applied in restoring or reestablishing corner:


FOUND A MONUMENT BOX WITH A 1/2" REROD INSIDE PER WITNESSES FROM PART "A" ABOVE: (F) EAST 36.5' TO THE NORTH EAST CORNER OF SECTION 5, T.4N., R.15E. (A)(D)(E)(G)(J)(M) NORTH EAST NAIL IN POWER POLE 72.17' (C)(G)(K) 52.9' NORTH NORTH WEST TO PK IN DETROIT EDISON POLE (M) 72.2' NORTH EAST TO NAIL IN DETROIT EDISON POLE (M)

PA 345-1990 PEER COMMITTEE APPROVED 12-15-99

C. Description of monument for corner and accessories established to perpetuate locating the position of the corner:

SET A 2" DIAMETER ALUMINUM CAP WITH MAGNET ATTACHED & INSCRIBED "ST. CLAIR COUNTY OFFICIAL CORNER" ON THE EXISTING 1/2" REROD & WITNESSES WERE TAKEN: NORTH EAST 71.97' TO COUNTY TAG IN POWER POLE SOUTH EAST 64.14' TO COUNTY TAG IN GAS MARKER SOUTH WEST 49.16' TO COUNTY TAG IN POWER POLE NORTH WEST 52.8' TO COUNTY TAG IN POWER POLE

THE SELECTED LOCATION IS ACCEPTED BY ME AND IS GENERALLY ACCEPTED BY PROFESSIONAL SURVEYORS AS THE BEST AVAILABLE EVIDENCE OF THE POSITION OF THE ORIGINAL CORNER.

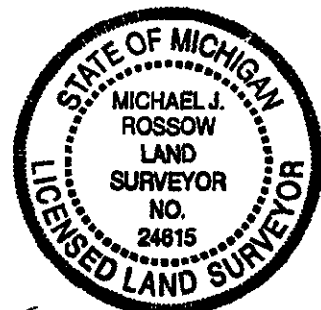

Signed by [Signature] Surveyor's Michigan License No. 24615

Date 12-17-99



ST. CLAIR COUNTY, MICHIGAN
OFFICIAL GOVERNMENT CORNER

SURVEY &
REMONUMENTATION

MAR 15 2000

SECTION

LAND CORNER RECORDATION CERTIFICATE
Filing Requirement of Act 74, Mich. P.A. 1970

	Located In:		Corner Code #
	COLUMBUS	TOWNSHIP	
1. Public Land Survey	T <u>5N</u>	R <u>15E</u>	<u>E-13</u>
	T _____	R _____	_____
2. Property Controlling in Section	S _____	T _____	R _____
	S _____	T _____	R _____
3. Miscellaneous Property in Sec.	S _____	T _____	R _____
	S _____	T _____	R _____

Register of Deeds Stamp & File Number

- (G) 1979, H. KOBBS SURVEY L.6, P.397 ("IRON BAR" WITH WITNESSES CONTAINED IN LCRC L.3, P.103)
- (H) 1987, D. LITTLE SURVEY L.13, P.195 (FINDS "PK" NAIL - DOES NOT WITNESS)
- (I) ST. CLAIR COUNTY ROAD COMMISSION PLANS OF 07-07-1993
- (J) 1975, H. KOBBS LCRC L.3, P.302 ("IRON BAR" WITH WITNESSES CONTAINED IN LCRC L.3, P.203)
- (K) 1975, H. KOBBS LCRC L.3, P.297 ("IRON BAR" WITH WITNESSES CONTAINED IN LCRC L.3, P.203)
- (L) 1977, L. THOMAS UNRECORDED SURVEY (NO ID, NO WITNESSES)
- (M) 1991, DCE (G. JAMES) L.S. #19835 UNRECORDED SURVEY (FINDS & WITNESSES "LARGE PK & WASHER")

