

ST. CLAIR COUNTY, MICHIGAN OFFICIAL GOVERNMENT CORNER



LAND CORNER RECORDATION CERTIFICATE Filing Requirement of Act 74, Mich. P.A. 1970

| | | |
|------------------------------------|--------------------------|----------------|
| | Located In: | Corner Code # |
| | St. Clair Twp. | |
| 1. Public Land Survey | T <u>5N</u> R <u>16E</u> | <u>A-1</u> |
| | T _____ R _____ | _____ |
| | T _____ R _____ | _____ |
| | T _____ R _____ | <u>Seg. #1</u> |
| 2. Property Controlling in Section | S _____ T _____ R _____ | _____ |
| | S _____ T _____ R _____ | _____ |
| 3. Miscellaneous Property in Sec. | S _____ T _____ R _____ | _____ |
| | S _____ T _____ R _____ | _____ |

RECEIVED
 REGISTER OF DEEDS
 ST. CLAIR COUNTY
 1993 DEC 29 AM 9:00

Register of Deeds Stamp & File Number

4. Lot No. _____, Recorded Plat _____
 5. Private Claims _____

| | | | | | | | | | | | | | |
|----|----|----|----|----|----|----|---|---|---|---|---|---|---|
| | A | B | C | D | E | F | G | H | I | J | K | L | M |
| 2 | 6 | 5 | 4 | 3 | 2 | 1 | | | | | | | |
| 3 | | | | | | | | | | | | | |
| 4 | 7 | 8 | 9 | 10 | 11 | 12 | | | | | | | |
| 5 | | | | | | | | | | | | | |
| 6 | 18 | 17 | 16 | 15 | 14 | 13 | | | | | | | |
| 7 | | | | | | | | | | | | | |
| 8 | 19 | 20 | 21 | 22 | 23 | 24 | | | | | | | |
| 9 | | | | | | | | | | | | | |
| 10 | 30 | 29 | 28 | 27 | 26 | 25 | | | | | | | |
| 11 | | | | | | | | | | | | | |
| 12 | 31 | 32 | 33 | 34 | 35 | 36 | | | | | | | |
| 13 | | | | | | | | | | | | | |

I, John R. Lansky in a field survey on Sept. 14-18 1993
 do hereby certify that under requirements of P.A. 74, Michigan P.A. of 1970, the corner points mentioned in lines 1 and 2 above were in conformance with regulations and rules therefore as required in the current manual of survey instructions of the United States Department of the Interior, Bureau of Land Management or by a decree of a Court of Law and/or that the corner points mentioned in lines 3, 4 and 5 above were in conformance with the rules of the Michigan Board of Land Surveyors or by a Decree of a Court of Law; established, re-established, monumented, re-monumented, recovered, found as expressed below:

NOTE: Not more than 1 corner, may be recorded on this certificate.

A. Description of original monument and accessories and/or subsequent restoration:

1. 3" Ironwood- Per Original Gov't Survey.
2. Concrete Monument- Per County Rec. (1936)

STATE PLAIN COORDINATES

N. _____
 E. _____
 ELEVATION _____

This Corner is Common to Four Twps. and Certificates are being filed for each twp.

B. Description of corner evidence found and/or method applied in restoring or reestablishing corner:

Found Concrete Monument with rod inserted to raise closer to surface.

Note: This concrete monument does not agree in location with certificate filed by RLS 7914 in L.4 P.287. That point lies 4.27 ft. S.E.'ly and was set as a road P.I. (Reference A.D. Road Plans No. 53 and 106)


2159A000 12/29/93MSSU4 7.00
 0001

C. Description of monument for corner and accessories established to perpetuate locating the position of the corner:

Concrete Monument (With Iron Rod Inserted)

2159A000 12/29/93MSSU4 2.00
 0001

- N.W. 43.57 ft. Set PK Nail with County Tag in D.E. Pole
- N.E. 67.8 ft. to center of Sun Pipe line marker.
- S.E. 77.4 ft. to N.W. Corner of Conc. Headwall (N/s)
- S.W. 77.7 ft. to N.E. Corner of N/S. Conc. Headwall.

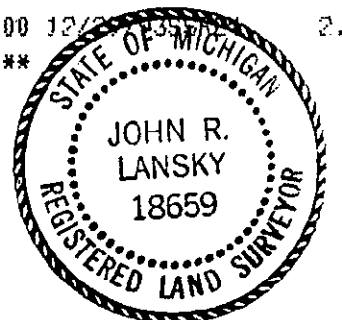

Signed by John R. Lansky
 Surveyor's Michigan License No. 18659

Date Sept. 20, 1993

PA 345-1990
 PEER COMMITTEE

APPROVED 11-30-93

APPROVED AS AN OFFICIAL GOVERNMENT CORNER BY ST. CLAIR COUNTY:

Signed By: _____
 St. Clair County Land Surveyor

Date

Surveyor's Michigan License No. _____