

ST. CLAIR COUNTY, MICHIGAN OFFICIAL GOVERNMENT CORNER



LAND CORNER RECORDATION CERTIFICATE
Filing Requirement of Act 74, Mich. P.A. 1970

Located In: _____ Corner Code # _____

- | | | | | | | | |
|------------------------------------|---|-----------------------|---|-------|-------|-------|-------|
| | | St. Clair Twp. | | | | | |
| 1. Public Land Survey | T | 5N. | R | 16E. | - | A-1 | ----- |
| | T | ----- | R | ----- | ----- | ----- | ----- |
| | T | ----- | R | ----- | ----- | ----- | ----- |
| | T | ----- | R | ----- | ----- | ----- | ----- |
| 2. Property Controlling in Section | S | ----- | T | ----- | R | ----- | ----- |
| | S | ----- | T | ----- | R | ----- | ----- |
| 3. Miscellaneous Property in Sec. | S | ----- | T | ----- | R | ----- | ----- |
| | S | ----- | T | ----- | R | ----- | ----- |

Seg. #2

REGISTERED
 RECORDS
 ST. CLAIR COUNTY
 1995 MAR -4 11:10:25
 RECEIVED

Register of Deeds Stamp & File Number

4. Lot No. _____, Recorded Plat _____
5. Private Claims _____

Daniel E. Johnson Jan. 31 95

I, _____, in a field survey on _____, 19 _____, do hereby certify that under requirements of P.A. 74, Michigan P.A. of 1970, the corner points mentioned in lines 1 and 2 above were in conformance with regulations and rules therefore as required in the current manual of survey instructions of the United States Department of the Interior, Bureau of Land Management or by a decree of a Court of Law and/or that the corner points mentioned in lines 3, 4 and 5 above were in conformance with the rules of the Michigan Board of Land Surveyors or by a Decree of a Court of Law; established, re-established, monumented, re-monumented, recovered, found as expressed below:

NOTE: Not more than 1 corner, may be recorded on this certificate.

	A	B	C	D	E	F	G	H	I	J	K	L	M
2	6	5	4	3	2								
3													
4	7	8	9	10	11	12							
5													
6	18	17	16	15	14	13							
7													
8	19	20	21	22	23	24							
9													
10	30	29	28	27	26	25							
11													
12	31	32	33	34	35	36							
13													

A. Description of original monument and accessories and/or subsequent restoration:

LIBER 007 PAGE 86

STATE PLAIN COORDINATES


N. _____

E. _____

ELEVATION _____

B. Description of corner evidence found and/or method applied in restoring or reestablishing corner:

LIBER 007 PAGE 86

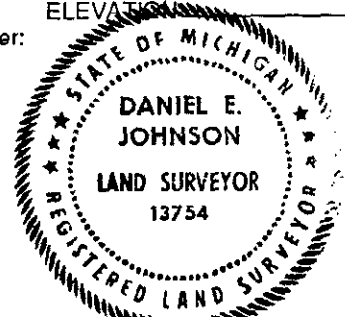

C. Description of monument for corner and accessories established to perpetuate locating the position of the corner:

Set 2" dia. aluminum cap inscribed "St. Clair County Official Corner" with magnet. (in Monument Box) on a Concrete Monument (with Iron Rod Inserted)
 N.W. 43.57 FT. Set PK Nail with County Tag in D.E. Pole
 N.E. 67.8 ft. t center of Sun Pipe Line marker.
 S.E. 77.4 ft. to N.W. corner of Conc. Headwall (N/s)
 S.W. 77.7 ft. to N.E. Corner of N/S Conc. Headwall

Signed by *Daniel E. Johnson*
Daniel E. Johnson
 13754
 Surveyor's Michigan License No. _____

Date January 31, 1995

APPROVED AS AN OFFICIAL GOVERNMENT CORNER BY ST. CLAIR COUNTY:

Signed By: *Daniel E. Johnson*
Daniel E. Johnson
 St. Clair County Land Surveyor
 13754
 Surveyor's Michigan License No. _____

PA 345-1990
PEER COMMITTEE
APPROVED 11-30-93
7-31-95
 Date _____
LIBER 008 PAGE 185