

REMONUMENTATION

DEC 02 1997

COMMISSION

ST. CLAIR COUNTY, MICHIGAN OFFICIAL GOVERNMENT CORNER



LAND CORNER RECORDATION CERTIFICATE Filing Requirement of Act 74, Mich. P.A. 1970

REGISTERED
ST. CLAIR COUNTY
1997 AUG 21 AM 7:25
PROPERTY
DEPARTMENT

	Located In:	Corner Code #
1. Public Land Survey	ST. CLAIR TWP. T <u>5N</u> R <u>16E</u>	<u>D-1</u>
2. Property Controlling in Section	S _____ T _____ R _____	_____
3. Miscellaneous Property in Sec.	S _____ T _____ R _____	_____
4. Lot No. _____, Recorded Plat _____	S _____ T _____ R _____	_____
5. Private Claims _____	S _____ T _____ R _____	_____

Register of Deeds Stamp & File Number

I, Michael J. Rossow, in a field survey on April 14, 1997, do hereby certify that under requirements of P.A. 74, Michigan P.A. of 1970, the corner points mentioned in lines 1 and 2 above were in conformance with regulations and rules therefore as required in the current manual of survey instructions of the United States Department of the Interior, Bureau of Land Management or by a decree of a Court of Law and/or that the corner points mentioned in lines 3, 4 and 5 above were in conformance with the rules of the Michigan Board of Land Surveyors or by a Decree of a Court of Law; established, re-established, monumented, re-monumented, recovered, found as expressed below:

A	B	C	D	E	F	G	H	I	J	K	L	M
2	6	5	4	3	2	1						
3												
4	7	8	9	10	11	12						
5												
6	18	17	16	15	14	13						
7												
8	19	20	21	22	23	24						
9												
10	30	29	28	27	26	25						
11												
12	31	32	33	34	35	36						
13												

NOTE: Not more than 1 CORNER, may be recorded on this certificate.

A. Description of original monument and accessories and/or subsequent restoration:

NO CORNER SET IN ORIGINAL GOVERNMENT SURVEY (1817). OLD ST. CLAIR COUNTY SURVEYOR'S RECORD SHOWS NOTHING FOR THIS CORNER (1942 ±)
ACT 74 CERTIFICATE FILED IN L.2,P.206 IDENTIFIES A "IRON PIPE" AS THE CORNER (1974)

B. Description of corner evidence found and/or method applied in restoring or reestablishing corner:


A 1/2" PIPE WAS FOUND PER CERTIFICATE FILED IN L.2,P.206 RECORDED WITNESSES VERIFIED WERE: 5/8" ROD S.1°28'40"W. 33.01'; 6" OAK N.46°E. 16.75'

VERIFIED SAME CORNER FROM ACT 132 CERT. (L.1,P.890, COLLINS) OF SURVEY.
VERIFIED SAME FROM UNRECORDED SURVEY BY C. MC DANIEL 12/23/93, WITNESSES FROM RAW FIELD NOTES - ALL VERIFIED.

PA 345-1990
PEER COMMITTEE
APPROVED 7-11-97

C. Description of monument for corner and accessories established to perpetuate locating the position of the corner: *DES.*

SET A 2" DIA. ALUMINUM CAP WITH MAGNET ATTACHED & INSCRIBED "ST. CLAIR COUNTY OFFICIAL CORNER" ON THE EXISTING 1/2" IRON PIPE AT THE CLOSING CORNER, WHICH LIES 17.13' NORTH OF AND NORMAL TO A LINE BETWEEN THE SOUTH 1/4 CORNER SEC. 32 AND THE S.E. CORNER OF SEC. 32, T.6N., R.16E.
E.S.E. 42.48' PK AND COUNTY TAG IN 10" CHERRY
S.E. 32.65' PK AND COUNTY TAG IN 20" OAK
N.E. 16.68' TO PK IN COUNTY TAG IN 6" ELM
W.N.W. 35.49' PK IN COUNTY TAG IN 8" OAK
W.S.W. 134.43 PK IN COUNTY TAG IN 10" ELM

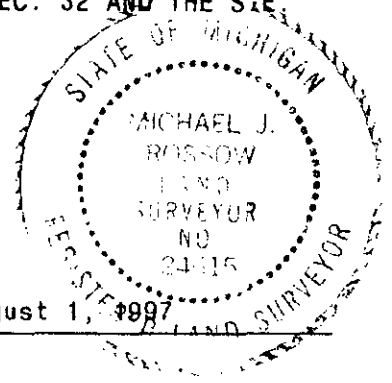

Signed by *[Signature]* Michael J. Rossow
Surveyor's Michigan License No. 24615

Date August 1, 1997