

SURVEY &  
REMONUMENTATION

# ST. CLAIR COUNTY, MICHIGAN OFFICIAL GOVERNMENT CORNER



DEC 02 1997

## LAND CORNER RECORDATION CERTIFICATE Filing Requirement of Act 74, Mich. P.A. 1970

COMMISSION

	Located In:	Corner Code #
	ST. CLAIR TWP.	
1. Public Land Survey	T <u>5N</u> R <u>16E</u>	<u>F-1</u>
	T _____ R _____	_____
2. Property Controlling in Section	S _____ T _____ R _____	_____
	S _____ T _____ R _____	_____
3. Miscellaneous Property in Sec.	S _____ T _____ R _____	_____
	S _____ T _____ R _____	_____
4. Lot No. _____, Recorded Plat _____		
5. Private Claims _____		

REGISTERED  
1997 AUG 21 AM 7:25  
REGISTER OF DEEDS  
ST. CLAIR COUNTY

Register of Deeds Stamp & File Number

I, Michael J. Rossow, in a field survey on April 16, 1997, do hereby certify that under requirements of P.A. 74, Michigan P.A. of 1970, the corner points mentioned in lines 1 and 2 above were in conformance with regulations and rules therefore as required in the current manual of survey instructions of the United States Department of the Interior, Bureau of Land Management or by a decree of a Court of Law and/or that the corner points mentioned in lines 3, 4 and 5 above were in conformance with the rules of the Michigan Board of Land Surveyors or by a Decree of a Court of Law; established, re-established, monumented, re-monumented, recovered, found as expressed below:

A	B	C	D	E	F	G	H	I	J	K	L	M
2	6	5	4	3	2	1						
3												
4	7	8	9	10	11	12						
5												
6	18	17	16	15	14	13						
7												
8	19	20	21	22	23	24						
9												
10	30	29	28	27	26	25						
11												
12	31	32	33	34	35	36						
13												

**NOTE: Not more than 1 CORNER, may be recorded on this certificate.**

**A. Description of original monument and accessories and/or subsequent restoration:**

A 6" BEECH TREE WAS ACCEPTED AS CORNER IN THE DIVISION THE T.5N., R.16E. SHOWN 2.5 CHAINS TO S. ¼ CORNER OF SEC. 33 T.6N., R.16E. (1817). OLD ST. CLAIR COUNTY SURVEYOR'S RECORD INDICATES A "LARGE STONE" ON TOP OF GROUND, WITH 5 WITNESSES ALL OF WHICH HAVE BEEN DESTROYED (1942). ACT 74 CERTIFICATE FILED IN L.4,P.86 (COLLINS) IDENTIFIES A "ROD" AS THE SECTION CORNER (1973).


**B. Description of corner evidence found and/or method applied in restoring or reestablishing corner:**

FOUND A 5/8" REROD PER ACT 74 CERT. L.4,P.86 (COLLINS) USING REMAINING WITNESS: S.70°W. 48.4' TO PK NAIL IN CORNER FENCE POST. VERIFIED CORNER FROM ACT 132 CERT. L.2,P.549 (COLLINS) SURVEY.

PA 345-1990  
PEER COMMITTEE  
APPROVED 7-11-97

**C. Description of monument for corner and accessories established to perpetuate locating the position of the corner:**

SET A 2" DIA. ALUMINUM CAP WITH MAGNET ATTACHED & INSCRIBED "ST CLAIR COUNTY OFFICIAL CORNER" ON THE EXISTING 5/8" REROD AT THE CLOSING CORNER WHICH LIES 4.70' SOUTH OF AND NORMAL TO A LINE BETWEEN THE S. ¼ CORNER OF SEC. 33 AND THE S.E. CORNER OF SEC. 33, T.6N., R.16E.  
S. 19.86' TO PK AND COUNTY TAG IN TWIN 10" POPLAR  
N.W. 35.65' TO PK AND COUNTY TAG IN MULTI 6" THORN APPLE  
E.N.E. 176.79' TO PK AND COUNTY TAG IN P. POLE  
S.W. 44.97' TO PK IN COUNTY TAG IN 8" ELM

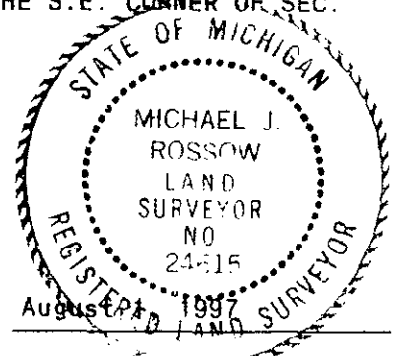

Signed by Michael J. Rossow Date August 21, 1997

Surveyor's Michigan License No. 24615