

SURVEY &  
REMONUMENTATION

ST. CLAIR COUNTY, MICHIGAN  
OFFICIAL GOVERNMENT CORNER



DEC 02 1997

COMMISSION

LAND CORNER RECORDATION CERTIFICATE  
Filing Requirement of Act 74, Mich. P.A. 1970

RECEIVED  
AUG 21 AM 7:25  
REGISTERED CLERK  
ST. CLAIR COUNTY

	Located In:	Corner Code #
1. Public Land Survey	ST. CLAIR TWP. T <u>5N</u> R <u>16E</u>	<u>G-1</u>
2. Property Controlling in Section	S _____ T _____ R _____	_____
3. Miscellaneous Property in Sec.	S _____ T _____ R _____	_____

Register of Deeds Stamp & File Number

4. Lot No. \_\_\_\_\_, Recorded Plat \_\_\_\_\_  
5. Private Claims \_\_\_\_\_

I, Michael J. Rossow, in a field survey on April 18, 1997, do hereby certify that under requirements of P.A. 74, Michigan P.A. of 1970, the corner points mentioned in lines 1 and 2 above were in conformance with regulations and rules therefore as required in the current manual of survey instructions of the United States Department of the Interior, Bureau of Land Management or by a decree of a Court of Law and/or that the corner points mentioned in lines 3, 4 and 5 above were in conformance with the rules of the Michigan Board of Land Surveyors or by a Decree of a Court of Law; established, re-established, monumented, re-monumented, recovered, found as expressed below:

	A	B	C	D	E	F	G	H	I	J	K	L	M
2	6	5	4	3	2	1							
3													
4	7	8	9	10	11	12							
5													
6	18	17	16	15	14	13							
7													
8	19	20	21	22	23	24							
9													
10	30	29	28	27	26	25							
11													
12	31	32	33	34	35	36							
13													

NOTE: Not more than 1 CORNER, may be recorded on this certificate.

A. Description of original monument and accessories and/or subsequent restoration:

A 30" PINE WAS MARKED AS THE ORIGINAL CORNER (1817): A LARGE STONE WAS INDICATED AS CORNER IN OLD ST. CLAIR COUNTY SURVEYOR'S RECORD (1942), ALL WITNESSES GONE; ACT 74 CERT. L.1,P.987 (1974) INDICATES A "3/4" CRIMPED PIPE" ACT 74 CERT. L.4,P.86 (1974) INDICATES AN "IRON" ACT 74 CERT. L.6,P.154 (1989) INDICATES A "3/4" PIPE" ACT 74 CERT. L.8,P.252 (1996) INDICATES A "IRON PIPE" ACT 132 CERTS. L.15,P.504, L.2,P.656, L.2,P.913, L.2,P.549, L.5,P.366 ALL IDENTIFY "IRON PIPE"


B. Description of corner evidence found and/or method applied in restoring or reestablishing corner: FOUND 1/2" PIPE PER ACT 74 CERTS. L.1,P.987, L.4,P.86, L.6,P.154; L.8,P.252 INCORRECTLY STATES THAT CORNER (G-1) IS ON LINE WITH SOUTH LINE OF SEC. 34 & 33, BUT IS THE CORRECT STATEMENT FOR CORNER H-1 WHICH IS RECORDED ON SAME CERTIFICATE ACT 74 L.1,P.987 WITNESS OF 61.7' N.W. SPIKE IN 12" OAK TREE, IS A 28" OAK WITH PK AT 61.7'. VERIFIED CORNER WITH CERT. SURVEYS L.2,P.656, L.2,P.913, L.14,P.528, L.15,P.504, L.2,P.549, L.5,P.366, L.5,P.373

PA 345-1990  
PEER COMMITTEE  
APPROVED 7-11-97

C. Description of monument for corner and accessories established to perpetuate locating the position of the corner: DEP.

SET A 2" DIA. ALUMINUM CAP WITH MAGNET ATTACHED & INSCRIBED "ST. CLAIR COUNTY OFFICIAL CORNER" ON THE EXISTING 1/2" PIPE AT THE CLOSING CORNER WHICH LIES 0.16' SOUTH OF AND NORMAL TO A LINE BETWEEN THE S.W. CORNER OF SEC. 34 AND THE SOUTH 1/4 CORNER OF SEC. 34, T.6N., R.16E.

S.E. 51.50' PK AND COUNTY TAG IN 26" PINE  
S.W. 41.65' PK AND COUNTY TAG IN 22" OAK  
WEST 6.55' PK AND COUNTY TAG IN 10" ELM  
E.N.E. 39.00' PK AND COUNTY TAG IN 10" ELM

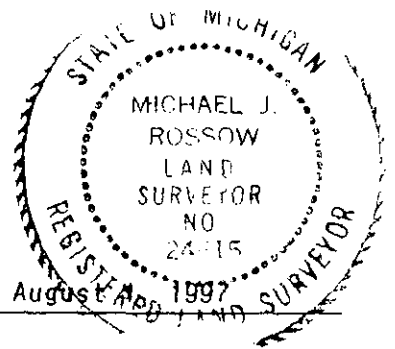

Signed by \_\_\_\_\_ Michael J. Rossow Date August 11 1997

Surveyor's Michigan License No. 24615