

REMONUMENTATION

# ST. CLAIR COUNTY, MICHIGAN OFFICIAL GOVERNMENT CORNER



DEC 0 2 1997

## LAND CORNER RECORDATION CERTIFICATE Filing Requirement of Act 74, Mich. P.A. 1970

COMMISSION

Located In: Corner Code #

		ST. CLAIR TWP.		
1. Public Land Survey	T	5N.	R 16E.	J-1
	T		R	
2. Property Controlling in Section	S	T	R	
	S	T	R	
3. Miscellaneous Property in Sec.	S	T	R	
	S	T	R	

Register of Deeds Stamp & File Number

4. Lot No. \_\_\_\_\_, Recorded Plat \_\_\_\_\_

5. Private Claims \_\_\_\_\_

I, Michael J. Rossow, in a field survey on April 22, 1997, do hereby certify that under requirements of P.A. 74, Michigan P.A. of 1970, the corner points mentioned in lines 1 and 2 above were in conformance with regulations and rules therefore as required in the current manual of survey instructions of the United States Department of the Interior, Bureau of Land Management or by a decree of a Court of Law and/or that the corner points mentioned in lines 3, 4 and 5 above were in conformance with the rules of the Michigan Board of Land Surveyors or by a Decree of a Court of Law; established, re-established, monumented, re-monumented, recovered, found as expressed below:

	A	B	C	D	E	F	G	H	I	J	K	L	M
2	6	5	4	3	2	1							
3													
4	7	8	9	10	11	12							
5													
6	18	17	16	15	14	13							
7													
8	19	20	21	22	23	24							
9													
10	30	29	28	27	26	25							
11													
12	31	32	33	34	35	36							
13													

**NOTE: Not more than 1 CORNER, may be recorded on this certificate.**

A. Description of original monument and accessories and/or subsequent restoration:

ORIGINAL GOVERNMENT NOTES RECORDS A 1/2 MILE POST WAS MADE ON A BEECH TREE 6" IN DIAMETER; NO BEARING TREES WERE RECORDED (1817). OLD ST. CLAIR COUNTY SURVEYOR'S RECORD DOES NOT IDENTIFY ACTUAL CORNER BUT RECORDS 3-WITNESSES TO THIS CORNER (1942). ACT 74 CERTIFICATE RECORDED IN L.1,P.705 (G. JAMES) RECORDS THAT HE SET A 1/2" REROD USING WITNESSES FROM ST. CLAIR COUNTY ROAD COMMISSION RECORDS FOUND IN FIELD BOOK #403, PW (1973) FOUND AND IDENTIFIED CORNER BY THESE WITNESSES.


B. Description of corner evidence found and/or method applied in restoring or reestablishing corner:

FOUND A 1/2" REROD WITH G. JAMES IDENTIFICATION CAP. RECORDED WITNESSES: 2' N. TO EDGE 10' GRAVEL ROAD; VERIFIED. 64.4' N.W. TO N. END 18" CMP; VERIFIED. ACT 132 CERTIFICATES RECORDED IN L.2,P.123, L.2,P.139 & L.12,P.449 ALL INDICATE THE SAME OR SIMILAR WITNESSES AND IDENTIFY THE SAME CORNER. ACT 132 CERTIFICATE L.12,P.371 DOES NOT RECORD ANY LOCAL WITNESSES DATA BUT INDICATES AN "IRON ROD" FOR CORNER.

PA 345-1990  
PEER COMMITTEE  
APPROVED 7-18-97  
DZJ.

C. Description of monument for corner and accessories established to perpetuate locating the position of the corner:

SET A 2" DIA. ALUMINUM CAP WITH MAGNET ATTACHED & INSCRIBED "ST. CLAIR COUNTY OFFICIAL CORNER" ON THE EXISTING 1/2" REROD AT THE CLOSING CORNER WHICH LIES 0.16' SOUTH OF AND NORMAL TO A LINE BETWEEN THE SOUTH 1/4 CORNER OF SECTION 35 & THE SOUTHEAST CORNER OF SECTION 35, T.6N., R.16E.  
22.15' N.W. TO PK IN COUNTY TAG IN 10" ASH  
29.14' S.W. TO PK IN COUNTY TAG IN 10" ASH  
68.91' N.N.E. TO PK IN COUNTY TAG IN 4" ASH  
64.70' S.E. TO PK IN COUNTY TAG IN 16" POPLAR

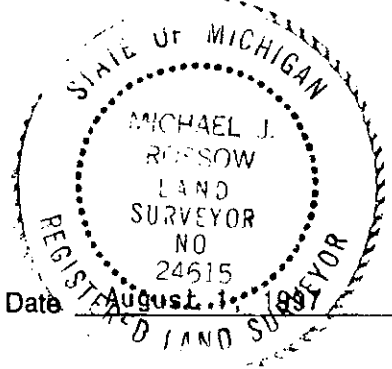

Signed by \_\_\_\_\_  
Surveyor's Michigan License No. \_\_\_\_\_

Michael J. Rossow Date \_\_\_\_\_

24615