

**ST. CLAIR COUNTY, MICHIGAN
OFFICIAL GOVERNMENT CORNER**



REGISTERED
ST. CLAIR COUNTY
RECORDED
21 MAR 7:25

**SURVEY &
REMONUMENTATION**

DEC 02 1997

**LAND CORNER RECORDATION CERTIFICATE
Filing Requirement of Act 74, Mich. P.A. 1970**

COMMISSION

	Located In:	Corner Code #
	ST. CLAIR TWP.	
1. Public Land Survey	T <u>5N</u> R <u>16E</u>	<u>L1</u>
	T _____ R _____	_____
2. Property Controlling in Section	S _____ T _____ R _____	_____
	S _____ T _____ R _____	_____
3. Miscellaneous Property in Sec.	S _____ T _____ R _____	_____
	S _____ T _____ R _____	_____
4. Lot No. _____, Recorded Plat _____		
5. Private Claims _____		

Register of Deeds Stamp & File Number

I, Michael J. Rossow, in a field survey on May 07, 1997, do hereby certify that under requirements of P.A. 74, Michigan P.A. of 1970, the corner points mentioned in lines 1 and 2 above were in conformance with regulations and rules therefore as required in the current manual of survey instructions of the United States Department of the Interior, Bureau of Land Management or by a decree of a Court of Law and/or that the corner points mentioned in lines 3, 4 and 5 above were in conformance with the rules of the Michigan Board of Land Surveyors or by a Decree of a Court of Law; established, re-established, monumented, re-monumented, recovered, found as expressed below:

	A	B	C	D	E	F	G	H	I	J	K	L	M
2	6	5	4	3	2	1							
3													
4	7	8	9	10	11	12							
5													
6	18	17	16	15	14	13							
7													
8	19	20	21	22	23	24							
9													
10	30	29	28	27	26	25							
11													
12	31	32	33	34	35	36							
13													

NOTE: Not more than 1 CORNER, may be recorded on this certificate.


A. Description of original monument and accessories and/or subsequent restoration:
NO CORNER WAS SET IN THE ORIGINAL GOVERNMENT SURVEY (1817). M.D.O.T. RIGHT-OF-WAY MAPS REFER & REFERENCE THIS CORNER (1930). THE OLD ST. CLAIR COUNTY SURVEYOR'S RECORD RECORDS A "1" IRON PIPE" AS THE CORNER WITH ONE WITNESS 67.6' TO 1/4 CORNER OF SEC. 36 KIMBALL (1942). AN ACT 74 CERTIFICATE IN L.2, P.407 RECORDS A 1" PIPE FOR CORNER (1974). ACT 132 SURVEY RECORDED IN L.1, P.121 COULD NOT LOCATE THIS CORNER (1972). ST. CLAIR COUNTY ROAD COMMISSION WITNESSES A CORNER (7-27-87) BY R. KREGER.

B. Description of corner evidence found and/or method applied in restoring or reestablishing corner:
FOUND A 5/8" REBAR PER M.D.O.T. MAP OF 1930± BY WITNESSES FROM S. ¼ CORNER SEC. 36, T.6N., R.16E., ALSO BY WITNESSES OF UNRECORDED SURVEY BY VALENTINE-THOMAS OF 1-18-77, N. TO NAIL & TAG IN BELL POLE 22.50', VERIFIED, 22.33' MEASURED; S.E. TO NAIL & TAG 24" WALNUT TREE 34.50', VERIFIED & MEASURED, BUT TREE SPECIES IS A 30" ASH; ALSO BY WITNESSES OF UNRECORDED SURVEY BY DUNN ENG. OF 10-08-79 46.0' EAST N.W. CORNER BLDG., VERIFIED, 45.8' MEASURED; 54.32' S.E. TO S.W. CORNER BLDG., VERIFIED 54.2' MEASURED; 22.9' N.E. TO MDSH TAG, VERIFIED; 34.50' S. TAG #5787 IN 30" ASH, VERIFIED; ALSO BY WITNESSES FROM UNRECORDED SURVEY BY G. JAMES OF 4-26-89, 46.0' EAST TO N.W. CORNER BLDG., VERIFIED, 45.8' MEASURED; 22.9' N.E. TAG POLE, VERIFIED; 34.5' SOUTH TAG 30" ASH, VERIFIED.

**PA 345-1990
PEER COMMITTEE
APPROVED 7-18-97**

C. Description of monument for corner and accessories established to perpetuate locating the position of the corner:
SET A 2" DIA. ALUMINUM CAP WITH MAGNET ATTACHED & INSCRIBED "ST. CLAIR COUNTY OFFICIAL CORNER" ON THE EXISTING 5/8" REBAR AT THE CLOSING CORNER WHICH LIES 3.03' SOUTH OF AND NORMAL TO A LINE BETWEEN THE S. ¼ CORNER & THE SOUTHEAST CORNER OF SECTION 36, T.6N., R.16E.

- 34.29' E.S.E. TO PK IN COUNTY TAG IN 30" ASH.
- 22.34' N.N.E. TO PK IN COUNTY TAG IN TELEPHONE POLE
- 151.93' N.W. TO PK IN COUNTY TAG IN DETROIT EDISON POLE
- 81.84' S.S.W. TO PK IN COUNTY TAG IN 18" ASH
- 67.50' W. TO S. 1/4 COR. SEC. 36, T.6N., R.16E.

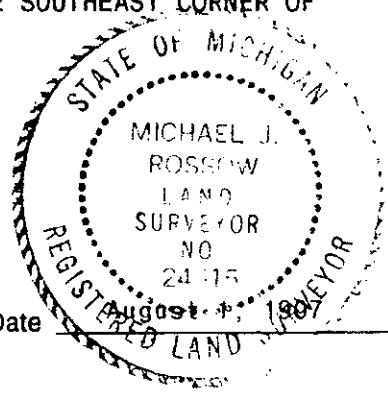

Signed by _____ Michael J. Rossow Date _____
Surveyor's Michigan License No. 24615