

RECEIVED  
ST. CLAIR COUNTY

ST. CLAIR COUNTY, MICHIGAN  
OFFICIAL GOVERNMENT CORNER



SEP 20 PM 2:20

LAND CORNER RECORDATION CERTIFICATE  
Filing Requirement of Act 74, Mich. P.A. 1970

	Located In:	Corner Code #
1. Public Land Survey	T <u>6N</u> R <u>13E</u>	<u>G-1</u>
	T _____ R _____	_____
	T _____ R _____	_____
	T _____ R _____	_____
2. Property Controlling in Section	S _____ T _____ R _____	<u>Dep. #1</u>
	S _____ T _____ R _____	_____
3. Miscellaneous Property in Sec.	S _____ T _____ R _____	_____
	S _____ T _____ R _____	_____

Register of Deeds Stamp & File Number

4. Lot No. \_\_\_\_\_, Recorded Plat \_\_\_\_\_  
5. Private Claims \_\_\_\_\_

	A	B	C	D	E	F	G	H	I	J	K	L
2	6	5	4	3	2	1						
3												
4	7	8	9	10	11	12						
5												
6	18	17	16	15	14	13						
7												
8	19	20	21	22	23	24						
9												
10	30	29	28	27	26	25						
11												
12	31	32	33	34	35	36						
13												

Michael J. Rossow May 9, 1994

I, \_\_\_\_\_, in a field survey on \_\_\_\_\_, 19\_\_\_\_, do hereby certify that under requirements of P.A. 74, Michigan P.A. of 1970, the corner points mentioned in lines 1 and 2 above were in conformance with regulations and rules therefore as required in the current manual of survey instructions of the United States Department of the Interior, Bureau of Land Management or by a decree of a Court of Law and/or that the corner points mentioned in lines 3, 4 and 5 above were in conformance with the rules of the Michigan Board of Land Surveyors or by a Decree of a Court of Law; established, re-established, monumented, re-monumented, recovered, found as expressed below:

NOTE: Not more than 1 corner, may be recorded on this certificate.

A. Description of original monument and accessories and/or subsequent restoration:

"Post set for original corner (Gov't Survey).

St. Clair Co. Surveyors Record List a found corner. and recites witness (All witnesses now destroyed).

Act 74 Cert. filed L.4,P.2 lists a 5/8" Rerod; L.05,P.44 lists 1/2" pipe over 1/2" Rod; L.5,P.291 list a 5/8" Rerod.

B. Description of corner evidence found and/or method applied in restoring or reestablishing corner:

Found 1/2" pipe per Cert. filed L.4,P.2, L.4,P.44, and Subsequent Act 74 Cert. filed in L.5,P.291.

C. Description of monument for corner and accessories established to perpetuate locating the position of the corner:

1/2" pipe. (2.66' North of a line between section corners. SW 34, S 1/4 34, T.7N.R.13E.)

- 178.37' ENE to set P.K. and County Tag in Underground Tele Riser Post
- 166.14' NE to set P.K. and County Tag in 8" Elm.
- 54.09' S to set P.K. and County Tag in P. Pole.
- 198.59' WSW to set P.K. and County Tag in P. Pole.
- 49.81 S #12043.

SEE ATTACHED SKETCH FOR ADDITIONAL INFORMATION.

Signed by Michael J. Rossow  
Surveyor's Michigan License No. 24615



Date May 13, 1994  
PA 345-1990  
PEER COMMITTEE  
APPROVED 6-17-94



APPROVED AS AN OFFICIAL GOVERNMENT CORNER BY ST. CLAIR COUNTY:

Signed By: \_\_\_\_\_ Date \_\_\_\_\_  
St. Clair County Land Surveyor

Surveyor's Michigan License No. \_\_\_\_\_

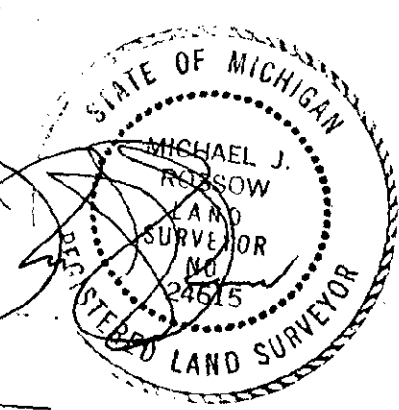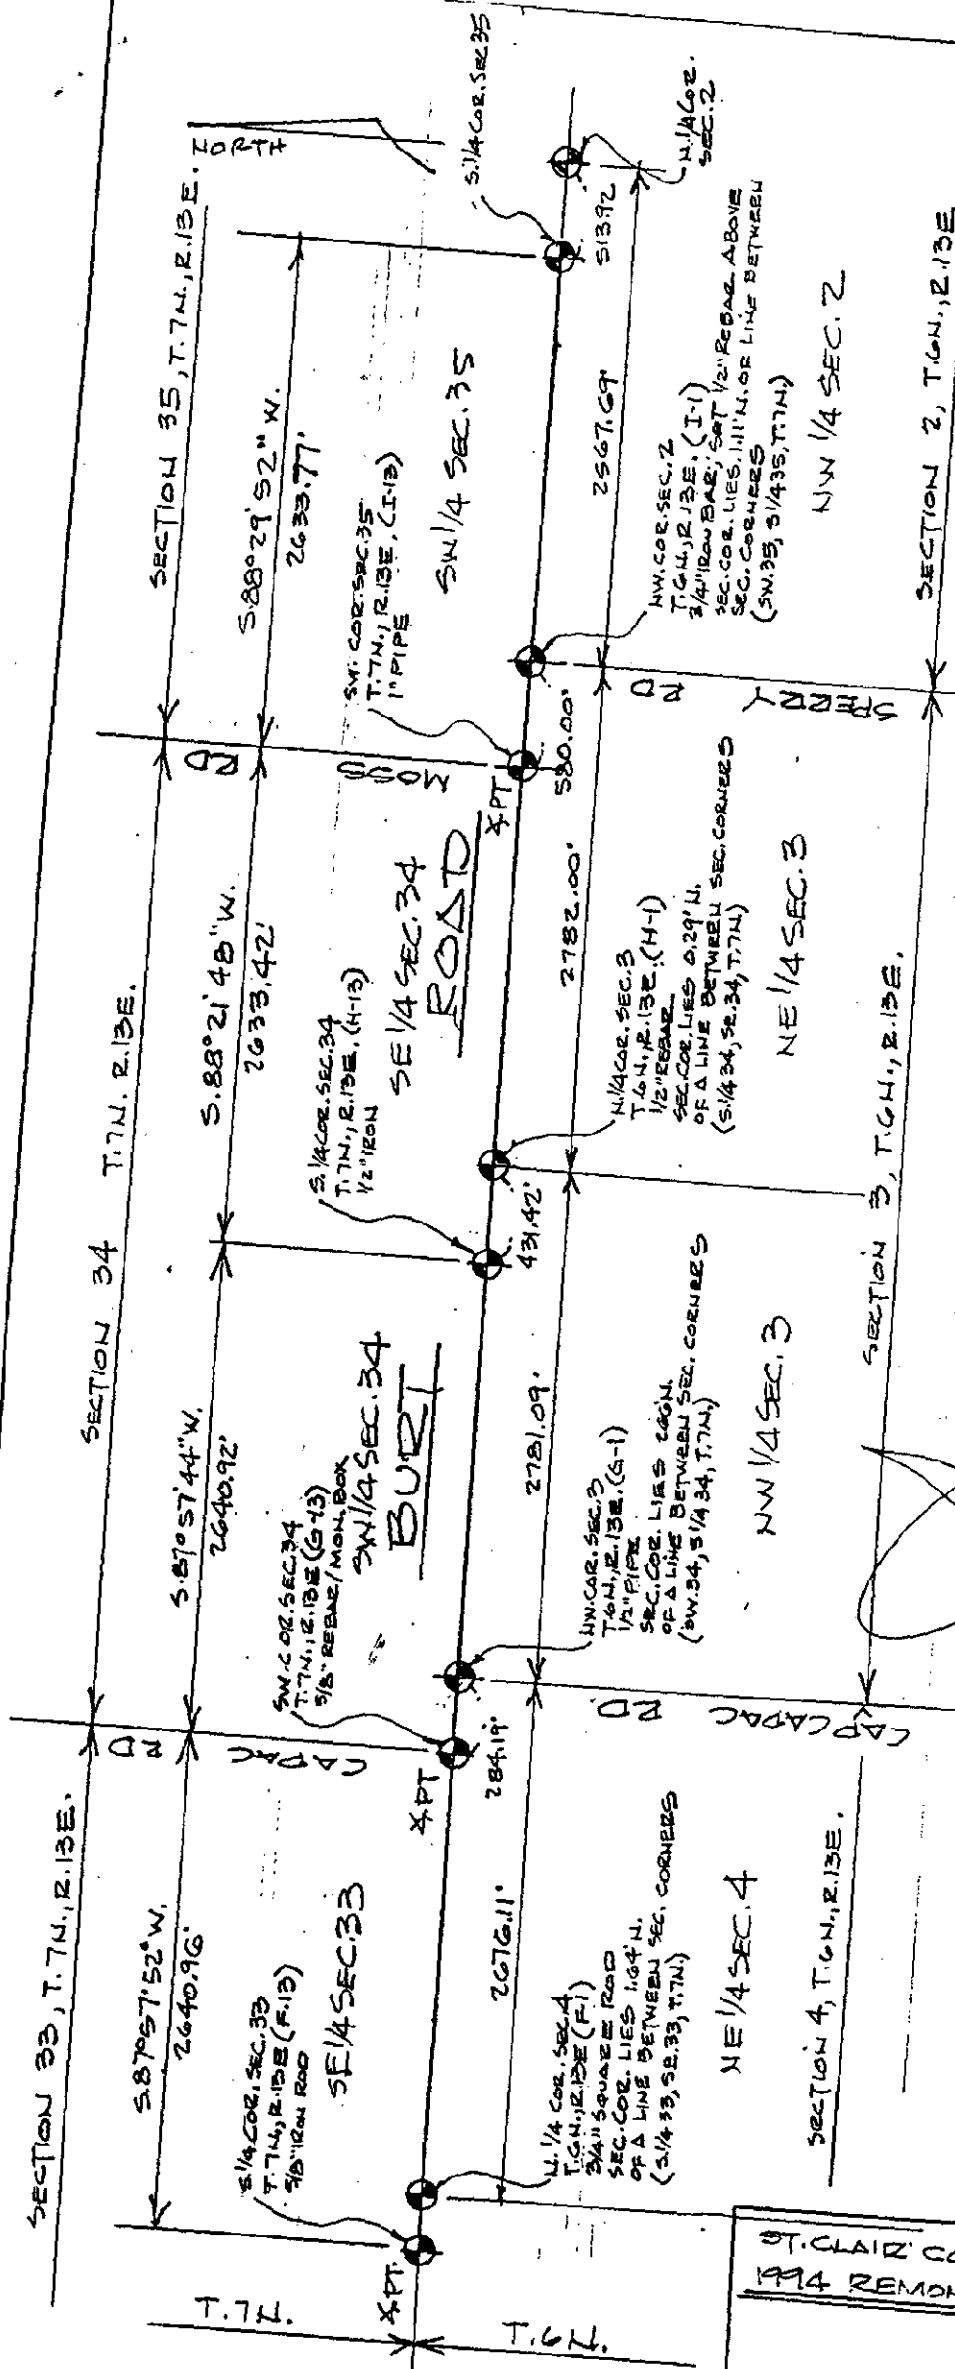

**LEGEND**

○	SET IRON
●	FOUND IRON
○	RECORDED
○	MEASURED
○	CALCULATED
—x—x—	FENCE
○	GOVT. CORNER

ST. CLAIR COUNTY, MICHIGAN  
1994 REMONUMENTATION PROGRAM

DR BY MZ	CR BY MZ	SHEET NO 6 OF SHEETS
SCALES 1" = 1000'		DATE 4-26-94
T.R. VALENTINE & ASSOCIATES INC. 901 Huron Ave. Suite 8 Consulting Engineers, Port Huron Michigan 48060 Mich/Recls & Land Surveyors (313) 985-4848		

NOTE: ALL DISTANCES & ANGLES  
MEASURED ELECTRONICALLY