

ST. CLAIR COUNTY, MICHIGAN OFFICIAL GOVERNMENT CORNER



LAND CORNER RECORDATION CERTIFICATE Filing Requirement of Act 74, Mich. P.A. 1970

	Located In:	Corner Code #	
	Berlin Twp.		
	6N 13E	G-1	
1. Public Land Survey	T _____ R _____	_____	_____
	T _____ R _____	_____	_____
	T _____ R _____	_____	_____
	T _____ R _____	_____	_____
2. Property Controlling in Section	S _____ T _____ R _____	Seg. #2	_____
	S _____ T _____ R _____	_____	_____
3. Miscellaneous Property in Sec.	S _____ T _____ R _____	_____	_____
	S _____ T _____ R _____	_____	_____
4. Lot No. _____, Recorded Plat _____			
5. Private Claims _____			

REGISTERED CLERK
ST. CLAIR COUNTY, MICHIGAN

1995 FEB - 11 AM 10:12

RECEIVED

Register of Deeds Stamp & File Number

I, Daniel E. Johnson February 7, 1995
do hereby certify that under requirements of P.A. 74, Michigan P.A. of 1970, the corner points mentioned in lines 1 and 2 above were in conformance with regulations and rules therefore as required in the current manual of survey instructions of the United States Department of the Interior, Bureau of Land Management or by a decree of a Court of Law and/or that the corner points mentioned in lines 3, 4 and 5 above were in conformance with the rules of the Michigan Board of Land Surveyors or by a Decree of a Court of Law; established, re-established, monumented, re-monumented, recovered, found as expressed below:

	A	B	C	D	E	F	G	H	I	J	K	L	M
2	6	5	4	3	2	1							
3													
4	7	8	9	10	11	12							
5													
6	18	17	16	15	14	13							
7													
8	19	20	21	22	23	24							
9													
10	30	29	28	27	26	25							
11													
12	31	32	33	34	35	36							
13													

NOTE: Not more than 1 corner, may be recorded on this certificate.

A. Description of original monument and accessories and/or subsequent restoration:

LIBER 007 PAGE 265

STATE PLAIN COORDINATES


N. _____

E. _____

B. Description of corner evidence found and/or method applied in restoring or reestablishing corner:

LIBER 007 PAGE 265

ELEVATION _____

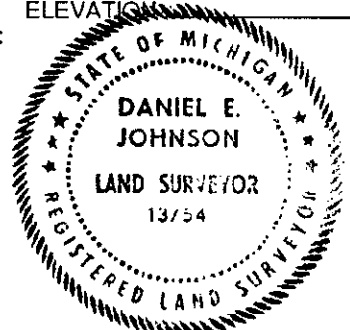

C. Description of monument for corner and accessories established to perpetuate locating the position of the corner:

Set with 2" dia. aluminum cap inscribed "St Clair County Official Corner" with magnet
on a
1/2" pipe. (2.66' North of line between section corners SW 34, S $\frac{1}{4}$ 34, T.7N., R.13E.)
178.37' ENE to set P.K. and County Tag in Underground Tele Riser Post
166.14' NE to set P.K. and County Tag in 8" Elm.
54.09' S to set P.K. and County Tag in P. Pole.
198.59' WSW to set P.K. and County Tag in P. Pole.
49.81 S #12043.

Signed by Daniel E. Johnson
Daniel E. Johnson
Surveyor's Michigan License No. 13754

Date February 7, 1995

PA 345-1990
PEER COMMITTEE

APPROVED 6-17-94 *[Signature]*

APPROVED AS AN OFFICIAL GOVERNMENT CORNER BY ST. CLAIR COUNTY:

Signed By: Daniel E. Johnson
St. Clair County Land Surveyor Daniel E. Johnson
13754

Date 7-25-95

Surveyor's Michigan License No. _____

LIBER 000 PAGE 70