


NOTE: ALL DISTANCES & ANGLES  
MEASURED ELECTRONICALLY

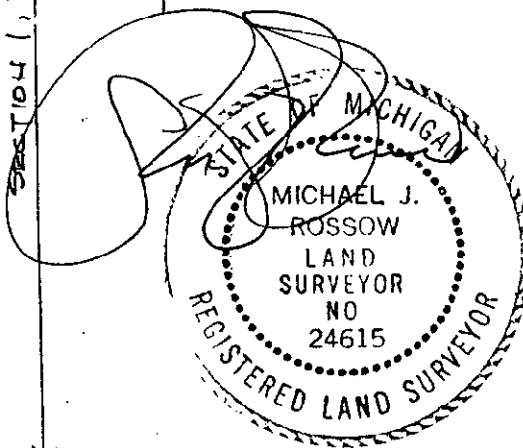

LEGEND

○	SET IRON
●	FOUND IRON
○	RECORDED
○	MEASURED
○	CALCULATED
—x—x—	FENCE
○	GOVT. CORNER

ST. CLAIR COUNTY, MICHIGAN  
1994 RE-MONUMENTATION PROGRAM

DR BY MZ	CK BY MZ	SHEET NO 5	OF	SHEETS
SCALES 1" = 1000'		DATE 4-26-94		

T.R. VALENTINE & ASSOCIATES INC. 901 Huron Ave., Suite B  
Consulting Engineers, Architects & Land Surveyors Port Huron Michigan 48061  
(313) 985-4848