

ST. CLAIR COUNTY, MICHIGAN OFFICIAL GOVERNMENT CORNER



LAND CORNER RECORDATION CERTIFICATE Filing Requirement of Act 74, Mich. P.A. 1970

RECEIVED
 REGISTER OF DEEDS
 ST. CLAIR COUNTY, MICHIGAN
 1995 APR - 4 PM 10: 11

	Located In:	Corner Code #	
	Berlin Twp.		
	6N 13E	K-1	
1. Public Land Survey	T _____ R _____	_____	_____
	T _____ R _____	_____	_____
	T _____ R _____	_____	_____
	T _____ R _____	_____	_____
2. Property Controlling in Section	S _____ T _____ R _____	<i>Seg. #2</i>	_____
	S _____ T _____ R _____	_____	_____
3. Miscellaneous Property in Sec.	S _____ T _____ R _____	_____	_____
	S _____ T _____ R _____	_____	_____

Register of Deeds Stamp & File Number

4. Lot No. _____, Recorded Plat _____
 5. Private Claims _____

	A	B	C	D	E	F	G	H	I	J	K	L	M
2	6	5	4	3	2	1							
3													
4	7	8	9	10	11	12							
5													
6	18	17	16	15	14	13							
7													
8	19	20	21	22	23	24							
9													
10	30	29	28	27	26	25							
11													
12	31	32	33	34	35	36							
13													

I, Daniel E. Johnson, in a field survey on February 7, 1995, do hereby certify that under requirements of P.A. 74, Michigan P.A. of 1970, the corner points mentioned in lines 1 and 2 above were in conformance with regulations and rules therefore as required in the current manual of survey instructions of the United States Department of the Interior, Bureau of Land Management or by a decree of a Court of Law and/or that the corner points mentioned in lines 3, 4 and 5 above were in conformance with the rules of the Michigan Board of Land Surveyors or by a Decree of a Court of Law; established, re-established, monumented, re-monumented, recovered, found as expressed below:

NOTE: Not more than 1 corner, may be recorded on this certificate.

A. Description of original monument and accessories and/or subsequent restoration:

LIBER 007 PAGE 257

STATE PLAIN COORDINATES


N. _____

E. _____

ELEVATION _____

B. Description of corner evidence found and/or method applied in restoring or reestablishing corner:

LIBER 007 PAGE 257

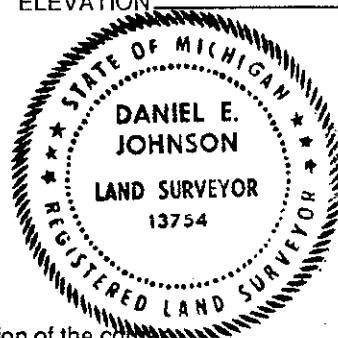

C. Description of monument for corner and accessories established to perpetuate locating the position of the corner:
 Set 2" dia. aluminum cap inscribed "St. Clair County Official Corner" with magnet
on a
 1/2" Rebar. (2.80' South of line between section corners SW 36, S $\frac{1}{2}$ 35, T.7N., R.13E.)
 89.53' NW to set P.K. and County Tag in P.Pole, above MDSH Tag.
 71.51' SW to set P.K. and County Tag in 15" Maple, above F. P.K.
 240.63' SSE to set P.K. and County Tag in Tele Pole.
 262.37' ENE to set P.K. and County Tag in P.Pole.

Signed by *Daniel E. Johnson* Daniel E. Johnson Date February 7, 1995
 Surveyor's Michigan License No. 13754

PA 345-1990
 PEER COMMITTEE *Daniel*

APPROVED 6-17-94

APPROVED AS AN OFFICIAL GOVERNMENT CORNER BY ST. CLAIR COUNTY:

Signed By: *Daniel E. Johnson* Daniel E. Johnson
 St. Clair County Land Surveyor 13754

July 25, 1995
 Date

LIBER 008 PAGE 60