


T. 7 N. R. 13 E.

SECTION 35, T. 7 N. R. 13 E.

SECTION 36, T. 7 N. R. 13 E.

SECTION 35, T. 7 N. R. 13 E.

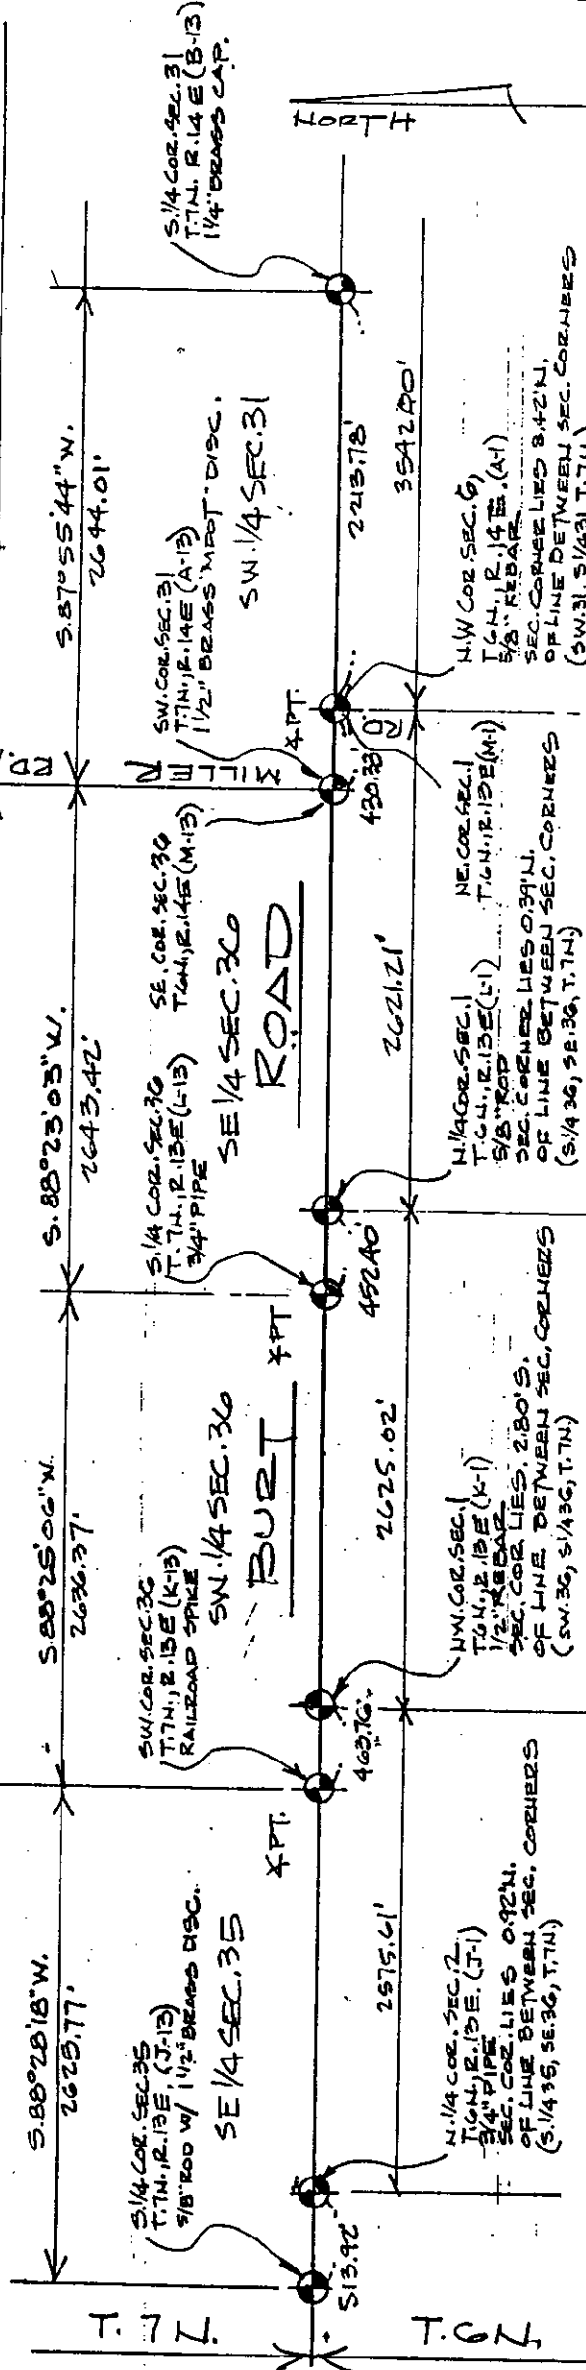

NOTE: ALL DISTANCES & ANGLES MEASURED ELECTRONICALLY

NE 1/4 SEC. 1

NE 1/4 SEC. 1

NE 1/4 SEC. 1

NE 1/4 SEC. 2

NE 1/4 SEC. 2

SECTION 6, T. 6 N. R. 14 E.

SECTION 1, T. 6 N. R. 13 E.

SECTION 2, T. 6 N. R. 13 E.

SECTION 2, T. 6 N. R. 13 E.

SECTION 6, T. 6 N. R. 14 E.


T. 6 N. R. 14 E.

T. 6 N. R. 13 E.

T. 6 N. R. 13 E.

T. 6 N. R. 13 E.

T. 6 N. R. 14 E.

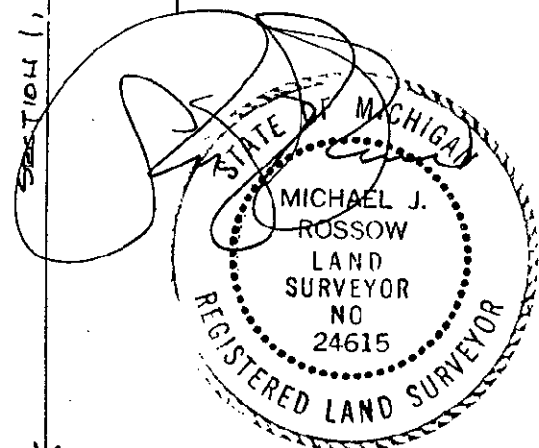

LEGEND

○	SET IRON
●	FOUND IRON
○	RECORDED
○	MEASURED
○	CALCULATED
—x—x—	FENCE
○	GOVT. CORNER

ST. CLAIR COUNTY, MICHIGAN
1994 REMONUMENTATION PROGRAM

DR BY	MZ	CK BY	MZ	SHEET NO	5	OF	SHEETS
SCALES	1" = 1000'	DATE	4-26-94				

T.R. VALENTINE & ASSOCIATES INC. 901 Huron Ave., Suite 8
Consulting Engineers, Port Huron Michigan 48060
Architects & Land Surveyors (313) 985-4848

DWG NO	JOB NO	DATE
		05-1