

ST. CLAIR COUNTY, MICHIGAN OFFICIAL GOVERNMENT CORNER



LAND CORNER RECORDATION CERTIFICATE Filing Requirement of Act 74, Mich. P.A. 1970

	Located In:	Corner Code #	
	Berlin Twp.	D-1	
	6N 13E	D-1	
1. Public Land Survey	T _____ R _____	_____	_____
	T _____ R _____	_____	_____
	T _____ R _____	_____	_____
	T _____ R _____	_____	_____
2. Property Controlling in Section	S _____ T _____ R _____	<i>Seg. #2</i>	_____
	S _____ T _____ R _____	_____	_____
3. Miscellaneous Property in Sec.	S _____ T _____ R _____	_____	_____
	S _____ T _____ R _____	_____	_____

RECEIVED
1995 AUG - 4 AM 10:12
REGISTER OF DEEDS
ST. CLAIR COUNTY
Register of Deeds Stamp & File Number

4. Lot No. _____, Recorded Plat _____
5. Private Claims _____

A	B	C	D	E	F	G	H	I	J	K	L	M
2	6	5	4	3	2	1						
3												
4	7	8	9	10	11	12						
5												
6	18	17	16	15	14	13						
7												
8	19	20	21	22	23	24						
9												
10	30	29	28	27	26	25						
11												
12	31	32	33	34	35	36						
13												

I, **Daniel E. Johnson**, in a field survey on **February 9,** 19**95**, do hereby certify that under requirements of P.A. 74, Michigan P.A. of 1970, the corner points mentioned in lines 1 and 2 above were in conformance with regulations and rules therefore as required in the current manual of survey instructions of the United States Department of the Interior, Bureau of Land Management or by a decree of a Court of Law and/or that the corner points mentioned in lines 3, 4 and 5 above were in conformance with the rules of the Michigan Board of Land Surveyors or by a Decree of a Court of Law; established, re-established, monumented, re-monumented, recovered, found as expressed below.

NOTE: Not more than 1 corner, may be recorded on this certificate.

A. Description of original monument and accessories and/or subsequent restoration:

LIBER 007 PAGE 271

STATE PLAIN COORDINATES


N. _____

E. _____

ELEVATION _____

B. Description of corner evidence found and/or method applied in restoring or reestablishing corner:

LIBER 007 PAGE 271

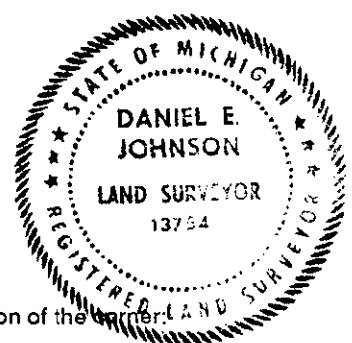

C. Description of monument for corner and accessories established to perpetuate locating the position of the corner:

Set 2" dia. aluminum cap inscribed "St. Clair County Official Corner" with magnet
on a
1/2" Iron, with #24615 Cap.

103.9' SW to set P.K. and County Tag in GTE Pole.
58.9' SE to set P.K. and County Tag in GTE Pole.
46.22' NE to set P.K. and County Tag in Mult. 12" Maple.
42.20' WNW to set P.K. and County Tag in Guard Rail Post(North West Most).
7.05' South to corner per Act 74 Cert.. filed in L.1,P.32.

Signed by *Daniel E. Johnson* Date February 9, 1995
Daniel E. Johnson
Surveyor's Michigan License No. 13754
PA 345-1990
PEER COMMITTEE
APPROVED 6-24-94 *Dante*

APPROVED AS AN OFFICIAL GOVERNMENT CORNER BY ST. CLAIR COUNTY:

Signed By: *Daniel E. Johnson* : 7-25-95
St. Clair County Land Surveyor Daniel E. Johnson Date
13754