

ST. CLAIR COUNTY, MICHIGAN OFFICIAL GOVERNMENT CORNER



LAND CORNER RECORDATION CERTIFICATE Filing Requirement of Act 74, Mich. P.A. 1970

	Located In:		Corner Code #
	6N	14E	A-1
1. Public Land Survey	T	R	_____
	T	R	_____
	T	R	_____
	T	R	_____
2. Property Controlling in Section	S	T	R
	S	T	R
3. Miscellaneous Property in Sec.	S	T	R
	S	T	R

REGISTER OF DEEDS
ST. CLAIR COUNTY, MICHIGAN
1995 MAY 24 AM 10:31
FILE NUMBER

Register of Deeds Stamp & File Number

4. Lot No. _____, Recorded Plat _____
5. Private Claims _____

I, Daniel E. Johnson, in a field survey on May 23, 1995, do hereby certify that under requirements of P.A. 74, Michigan P.A. of 1970, the corner points mentioned in lines 1 and 2 above were in conformance with regulations and rules therefore as required in the current manual of survey instructions of the United States Department of the Interior, Bureau of Land Management or by a decree of a Court of Law and/or that the corner points mentioned in lines 3, 4 and 5 above were in conformance with the rules of the Michigan Board of Land Surveyors or by a Decree of a Court of Law; established, re-established, monumented, re-monumented, recovered, found as expressed below:

	A	B	C	D	E	F	G	H	I	J	K	L	M
2	6	5	4	3	2	1							
3													
4	7	8	9	10	11	12							
5													
6	18	17	16	15	14	13							
7													
8	19	20	21	22	23	24							
9													
10	30	29	28	27	26	25							
11													
12	31	32	33	34	35	36							
13													

NOTE: Not more than 1 corner, may be recorded on this certificate.

A. Description of original monument and accessories and/or subsequent restoration:

LIBER 007 PAGE 301

STATE PLAIN COORDINATES


N. _____

E. _____

ELEVATION _____

B. Description of corner evidence found and/or method applied in restoring or reestablishing corner:

LIBER 007 PAGE 301

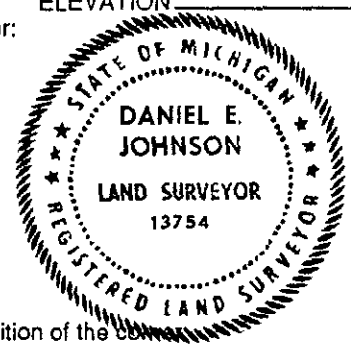

C. Description of monument for corner and accessories established to perpetuate locating the position of the corner:
 Set 2" Dia. Aluminum Cap inscribed "St. Clair County Official Corner" over 5/8" Rebar. (8.42' North to line between section corners, SW 31, S 1/4 31, T.7N., R.14E.)
 25.88' NW to set P.K. and County Tag in Underground Tele Support Pole.
 117.72' NNW to set P.K. and County Tag in W side of P.Pole. (F.P.K. in E side P)
 198.32' SW to set P.K. and County Tag in P.Pole.
 114.92' NE to set P.K. and County Tag in 15" Birch.
 12' N of centerline Burt Road/2' E centerline ASPH Dr N.

Signed by Daniel E. Johnson Date May 23, 1995
 Daniel E. Johnson

Surveyor's Michigan License No. 13754

PA 345-1990
PEER COMMITTEE

APPROVED AS AN OFFICIAL GOVERNMENT CORNER BY ST. CLAIR COUNTY:

Signed By: Daniel E. Johnson
 Daniel E. Johnson
 St. Clair County Land Surveyor

APPROVED 6-17-94
7/25/95
 Date

Surveyor's Michigan License No. 13754

LIBER 008 PAGE 184