



	Located In:	Corner Code #
1. Public Land Survey	T <u>6N</u> R <u>14E</u>	<u>C-1</u>
	T _____ R _____	_____
	T _____ R _____	_____
	T _____ R _____	_____
2. Property Controlling in Section	S _____ T _____ R _____	<u>Seg. #1</u>
	S _____ T _____ R _____	_____
3. Miscellaneous Property in Sec.	S _____ T _____ R _____	_____
	S _____ T _____ R _____	_____

Register of Deeds Stamp & File Number

4. Lot No. _____, Recorded Plat _____
 5. Private Claims _____

Michael J. Rossow April 29, 1994

I, _____, in a field survey on _____, 19____ do hereby certify that under requirements of P.A. 74, Michigan P.A. of 1970, the corner points mentioned in lines 1 and 2 above were in conformance with regulations and rules therefore as required in the current manual of survey instructions of the United States Department of the Interior, Bureau of Land Management or by a decree of a Court of Law and/or that the corner points mentioned in lines 3, 4 and 5 above were in conformance with the rules of the Michigan Board of Land Surveyors or by a Decree of a Court of Law; established, re-established, monumented, re-monumented, recovered, found as expressed below:

NOTE: Not more than 1 corner, may be recorded on this certificate.

A. Description of original monument and accessories and/or subsequent restoration:

6" Birch made for original corner (Govt. Survey).
 P. 145, 146
 "Large Stone" Identified in St. Clair Co. Surveyors Record.
 Act 74 Cert. filed L.3,P.331, L.4,P.46 (MDOT)
 L.4,P.276 Rescinds corner filed in L.4,P.129

B. Description of corner evidence found and/or method applied in restoring or reestablishing corner:

Found "Boat Spike" 1' deep in Monument Box per Cert. filed L.4,P.46.

C. Description of monument for corner and accessories established to perpetuate locating the position of the corner:

"Boat Spike" in Monument Box. (2.78' S of line between Sec. corners SW 32, S $\frac{1}{4}$ 32, T.7N.,R.14E.)
 101.72' SE to set P.K. and County Tag in P.Pole (1981).
 152.74' SSW to set P.K. and County Tag in 8" Poplar.
 242.49' SW to set P.K. and County Tag in P.Pole.
 95.55' WNW to set P.K. and County Tag in S R/R tie FE Post.
 1.5' E to Monument Box (County Road P.I.)

	A	B	C	D	E	F	G	H	I	J	K	L	I
2	6	5	4	3	2	1							
3													
4	7	8	9	10	11	12							
5													
6	18	17	16	15	14	13							
7													
8	19	20	21	22	23	24							
9													
10	30	29	28	27	26	25							
11													
12	31	32	33	34	35	36							
13													


STATE PLAIN COORDINATES

N. _____
 E. _____
 ELEVATION _____

SEE ATTACHED SKETCH FOR ADDITIONAL INFORMATION.

Signed by Michael J. Rossow
 Surveyor's Michigan License No. 24615

Date May 13, 1994
 PA 345-1990
 PEER COMMITTEE
 APPROVED 6-17-94

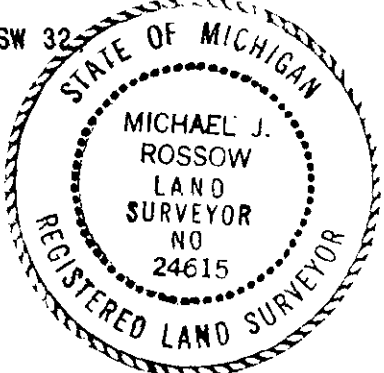

APPROVED AS AN OFFICIAL GOVERNMENT CORNER BY ST. CLAIR COUNTY:

Signed By: _____ Date _____
 St. Clair County Land Surveyor

