

**ST. CLAIR COUNTY, MICHIGAN  
OFFICIAL GOVERNMENT CORNER**



**LAND CORNER RECORDATION CERTIFICATE  
Filing Requirement of Act 74, Mich. P.A. 1970**

	Located In:	Corner Code #
1. Public Land Survey	T <u>6N</u> R <u>14E</u>	<u>E-1</u>
	T _____ R _____	_____
	T _____ R _____	_____
	T _____ R _____	_____
2. Property Controlling in Section	S _____ T _____ R _____	<u>Seg. #2</u>
	S _____ T _____ R _____	_____
3. Miscellaneous Property in Sec.	S _____ T _____ R _____	_____
	S _____ T _____ R _____	_____

Register of Deeds Stamp & File Number

4. Lot No. \_\_\_\_\_, Recorded Plat \_\_\_\_\_  
5. Private Claims \_\_\_\_\_

A	B	C	D	E	F	G	H	I	J	K	L
2	6	5	4	3	2	1					
3											
4	7	8	9	10	11	12					
5											
6	18	17	16	15	14	13					
7											
8	19	20	21	22	23	24					
9											
10	30	29	28	27	26	25					
11											
12	31	32	33	34	35	36					
13											

I, Daniel E. Johnson, in a field survey on April 26, 1994, do hereby certify that under requirements of P.A. 74, Michigan P.A. of 1970, the corner points mentioned in lines 1 and 2 above were in conformance with regulations and rules therefore as required in the current manual of survey instructions of the United States Department of the Interior, Bureau of Land Management or by a decree of a Court of Law and/or that the corner points mentioned in lines 3, 4 and 5 above were in conformance with the rules of the Michigan Board of Land Surveyors or by a Decree of a Court of Law, established, re-established, monumented, re-monumented, recovered, found as expressed below:

**NOTE: Not more than 1 corner, may be recorded on this certificate.**

A. Description of original monument and accessories and/or subsequent restoration:


LIBER 007 PAGE 293

STATE PLAIN COORDINATES

N. \_\_\_\_\_  
E. \_\_\_\_\_

B. Description of corner evidence found and/or method applied in restoring or reestablishing corner:

LIBER 007 PAGE 293

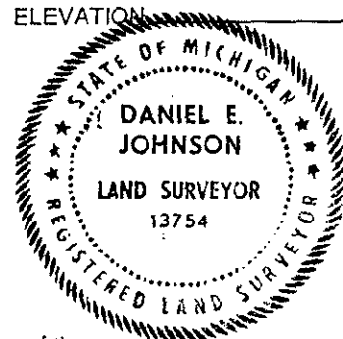

C. Description of monument for corner and accessories established to perpetuate locating the position of the corner:

"ACCEPTED MICHIGAN DEPARTMENT OF TRANSPORTATION BRASS DISC"  
MDOT 5/8" Rod with brass disk (1.75' North to line between section corners SW 33, S $\frac{1}{4}$  33, T.7N., R.14E.)  
68.42' SW to set P.K. and County Tag in P. Pole.  
52.86' SE to set P.K. and County Tag in Underground Tele Riser Post.  
129.13' WNW to set P.K. and County Tag in Corner FE Post.  
48.98' SW to set P.K. and County Tag in Underground Tele Riser Post.  
1.80' S to Axle Shaft & Corner Rec'd in L.6, P.243A.

Signed by Daniel E. Johnson Date April 26, 1994  
Surveyor's Michigan License No. 13754

PA 345-1990  
PEER COMMITTEE  
APPROVED 6-17-94  
*Daniel*

APPROVED AS AN OFFICIAL GOVERNMENT CORNER BY ST. CLAIR COUNTY:

Signed By: Daniel E. Johnson Date 7/25/95  
St. Clair County Land Surveyor Daniel E. Johnson  
13754

LIBER 008 PAGE 180

Surveyor's Michigan License No. \_\_\_\_\_