

RECEIVED  
REGISTERED

1994 SEP 20 PM 2:20

REGISTER OF DEEDS  
ST. CLAIR COUNTY

# ST. CLAIR COUNTY, MICHIGAN OFFICIAL GOVERNMENT CORNER



## LAND CORNER RECORDATION CERTIFICATE Filing Requirement of Act 74, Mich. P.A. 1970

	Located In:	Corner Code #
1. Public Land Survey	T <u>6N</u> R <u>14E</u>	<u>G-1</u>
	T _____ R _____	_____
	T _____ R _____	_____
	T _____ R _____	_____
2. Property Controlling in Section	S _____ T _____ R _____	<u>Seg # 1</u>
	S _____ T _____ R _____	_____
3. Miscellaneous Property in Sec.	S _____ T _____ R _____	_____
	S _____ T _____ R _____	_____

Register of Deeds Stamp & File Number

4. Lot No. \_\_\_\_\_, Recorded Plat \_\_\_\_\_  
 5. Private Claims \_\_\_\_\_

Michael J. Rossow

March 9, 1994

I, \_\_\_\_\_, in a field survey on \_\_\_\_\_, 19\_\_\_\_\_, do hereby certify that under requirements of P.A. 74, Michigan P.A. of 1970, the corner points mentioned in lines 1 and 2 above were in conformance with regulations and rules therefore as required in the current manual of survey instructions of the United States Department of the Interior, Bureau of Land Management or by a decree of a Court of Law and/or that the corner points mentioned in lines 3, 4 and 5 above were in conformance with the rules of the Michigan Board of Land Surveyors or by a Decree of a Court of Law; established, re-established, monumented, re-monumented, recovered, found as expressed below:

**NOTE: Not more than 1 corner, may be recorded on this certificate.**

A. Description of original monument and accessories and/or subsequent restoration:

12" Aspen made for original Govt. corner (G.L.O. P.138)

Ford Axle Shaft" identified on St. Clair Co. Surveyors Record.

Act 74 Cert. filed in L.4,P.171 & L.4,P.55 (MDOT)

B. Description of corner evidence found and/or method applied in restoring or reestablishing corner:

Found 5/8" bar with 1 1/2" brass disc per Cert. L.4,P.55.

C. Description of monument for corner and accessories established to perpetuate locating the position of the corner:

5/8" bar with 1 1/2" brass disc. (1.20' North to line between section corners SW 34, S 34, T.7N.,R.14E.)

74.51' SE to set P.K. and County Tag in P.Pole.

207.63' SSE to set P.K. and County Tag in 30" Tree.

385.06' ESE to set P.K. and County Tag in P.Pole.

361.88' WSW to set P.K. and County Tag in Tele Pole.

1" Iron pin 0.1'W & 0.05'S. & 0.15' above brass disk.

SEE ATTACHED SKETCH FOR ADDITIONAL INFORMATION.

Signed by Michael J. Rossow

Surveyor's Michigan License No. 24615

Date May 13, 1994

PA 345-1990

PEER COMMITTEE

APPROVED 6-17-94


	A	B	C	D	E	F	G	H	I	J	K	L
2	6		5		4		3		2		1	
3												
4	7		8		9		10		11		12	
5												
6	18		17		16		15		14		13	
7												
8	19		20		21		22		23		24	
9												
10	30		29		28		27		26		25	
11												
12	31		32		33		34		35		36	
13												

STATE PLAIN COORDINATES

N. \_\_\_\_\_

E. \_\_\_\_\_

ELEVATION \_\_\_\_\_

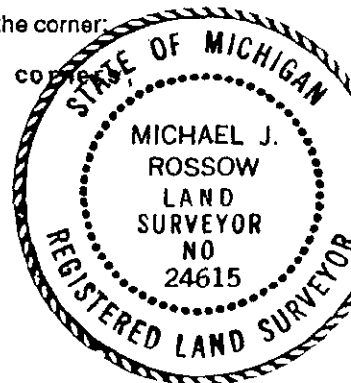

APPROVED AS AN OFFICIAL GOVERNMENT CORNER BY ST. CLAIR COUNTY:

Signed By: \_\_\_\_\_

St. Clair County Land Surveyor

Surveyor's Michigan License No. \_\_\_\_\_

LIBER 007 PAGE 289

