
## ST. CLAIR COUNTY, MICHIGAN OFFICIAL GOVERNMENT CORNER

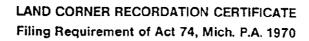



		Located In:	Corner Code ##		, ja - <del>177</del>	
1,	Public Land Survey ,	T <u>6N</u> R <u>14E</u> - T R T R		-	25 127 -1 150 25 17 -1 25 127 -1	~ . = ; : . :
	Property Controlling in Section Miscellaneous	T R S T R S T R S T R	Seg-#2	-		
<b>U</b> .	Property in Sec.	S T R		Register	of Deeds Stamp & Fi	le Number
4. 5.	Lot No, Rec Private Claims	corded Plat	<del></del>	A	B C D E F G F	1
				2 3	5 4 3	2
Ma abo co exp	hereby certify that under requi- lines 1 and 2 above were in or rrent manual of survey instruc- inagement or by a decree of a Coove were in conformance with ourt of Law, established, re- pressed below:	in a field survey on	of 1970, the corner points rid rules therefore as requitment of the Interior. Bureau points mentioned in lines of Land Surveyors or by a Dimonumented, recovered,	mentioned 6 au of Land 7 a. 3, 4 and 5 8	18 17 16 15 19 20 21 22 30 29 28 27	23 - 24 - 25 - 25
				12	31 32 33 34	35 36
A.	Description of original mor	nument and accessories and/o	r subsequent restoration	<b>!:</b>	STATE PLAIN COOR	RDINATES
		LIBER 007 PAGE	285			
В.	Description of corner evide	ence found and/or method app	lied in restoring or reest		LEVATION OF MICH	
		LIBER 007 PAGE	285		DANIEL E. JOHNSON LAND SURVEYOR 13754	10 x 0 x 0 x 0 x 0 x 0 x 0 x 0 x 0 x 0 x
c.	Description of monument	or corner and accessories est	ablished to perpetuate lo	ocating the position o	of the collections	
	"ACCEPTED MICH	HIGAN DEPARTMENT OF	TRANSPORTATION BE	RASS DISC"		
	5/8" Rod with	1 1/2" brass disc.				
	401.15' SSW 99.80' SW 56,56' ENE	to set P.K. and Cour to set P.K. and Cour to set P.K. and Cour to set P.K. and Cour erline gravel road (E	oty Tag in P. Pol oty Tag in P. Pol oty Tag in 12" Tr	e		
Siç	gned by	Danul Jah	uson	Date Febr	ruary 28, 1994	
Su	rveyor's Michigan License N	Daniel/E. J lo. 13754	Johnson		PA 345-1990 PEER COMMI	
AF	PPROVED AS AN OFFICIAL	. GOVERNMENT <del>ÇOR</del> NER B	Y SALOLAIR BOUNTY		APPROVED_6=/	7-74
	aned By:	()au	el Shuson	<u> </u>	7-25-95	
Su	St. Clair County urveyor's Michigan License N	Land Surveyor Daniel E. J 13754	onnson	LIBER	$008^{ ext{\tiny Date}}$	;