

**ST. CLAIR COUNTY, MICHIGAN
OFFICIAL GOVERNMENT CORNER**



**LAND CORNER RECORDATION CERTIFICATE
Filing Requirement of Act 74, Mich. P.A. 1970**

	Located In:	Corner Code #
1. Public Land Survey	T <u>6N</u> R <u>14E</u>	<u>M-1</u>
	T _____ R _____	_____
	T _____ R _____	_____
	T _____ R _____	_____
2. Property Controlling in Section	S _____ T _____ R _____	<u>Seg-#1</u>
	S _____ T _____ R _____	_____
3. Miscellaneous Property in Sec.	S _____ T _____ R _____	_____
	S _____ T _____ R _____	_____

RECEIVED
1993 DEC 29
REGISTER OF DEEDS STAMP & FILE NUMBER

4. Lot No. _____, Recorded Plat _____
5. Private Claims _____

A	B	C	D	E	F	G	H	I	J	K	L	M
2	6	5	4	3	2							
3												
4	7	8	9	10	11	12						
5												
6	18	17	16	15	14	13						
7												
8	19	20	21	22	23	24						
9												
10	30	29	28	27	26	25						
11												
12	31	32	33	34	35	36						
13												

David J. Little in a field survey on Sept. 27-30, 1993
do hereby certify that under requirements of P.A. 74, Michigan P.A. of 1970, the corner points mentioned in lines 1 and 2 above were in conformance with regulations and rules therefore as required in the current manual of survey instructions of the United States Department of the Interior, Bureau of Land Management or by a decree of a Court of Law and/or that the corner points mentioned in lines 3, 4 and 5 above were in conformance with the rules of the Michigan Board of Land Surveyors or by a Decree of a Court of Law; established, re-established, monumented, re-monumented, recovered, found as expressed below:

NOTE: Not more than 1 corner, may be recorded on this certificate.

A. Description of original monument and accessories and/or subsequent restoration:

Post-(Government Surveys)

**Nothing listed on Old Surveyor's Record.
St. Clair County.**

**5/8" Rod with 1 1/2" Brass Disc stamped RLS 14098 M.D.S.H.T.
Recorded in L.4 P.5 Recordation Certificates.**

STATE PLAIN COORDINATES

N. _____

E. _____

ELEVATION _____

B. Description of corner evidence found and/or method applied in restoring or reestablishing corner:

Found 5/8" Rod with 1 1/2" Brass Disc stamped RLS 14098 M.D.S.H.T.

Note: This Corner is common to two townships and certificates are being filed for each township.

2159A000 12/29/93KSSU4 9.00
0001


C. Description of monument for corner and accessories established to perpetuate locating the position of the corner:

5/8" Rod with 1 1/2" Brass Disc

2159A000 12/29/93SSRE4 2.00
0001

**E. 34.20' to set P.K. and County Tag in N face of fence post.
SE 91.65' to set P.K. and county Tag in NW face of D.E.P.
SSW 174.33' to set P.K. and County Tag in NE face of root of Oak.
NNE 96.45' to set P.K. and County Tag in W face of D.E.P.**

See attached sketch for additional information.

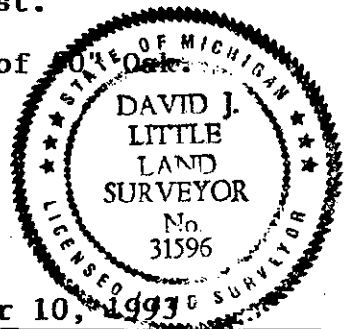

Signed by David J. Little
David J. Little
Surveyor's Michigan License No. 31596

Date December 10, 1993

**PA 345-1990
PEER COMMITTEE**

APPROVED AS AN OFFICIAL GOVERNMENT CORNER BY ST. CLAIR COUNTY:

APPROVED 12-14-93

Signed By: _____
St. Clair County Land Surveyor

Date

Surveyor's Michigan License No. _____