

ST. CLAIR COUNTY, MICHIGAN OFFICIAL GOVERNMENT CORNER



LAND CORNER RECORDATION CERTIFICATE Filing Requirement of Act 74, Mich. P.A. 1970

RECEIVED
 REGISTER OF DEEDS
 ST. CLAIR COUNTY, MICHIGAN
 JUN 10 1995

	Located In:		Corner Code #
	6N	14E	B-1
1. Public Land Survey	T _____	R _____	_____
	T _____	R _____	_____
	T _____	R _____	_____
	T _____	R _____	_____
2. Property Controlling in Section	S _____	T _____	R _____
	S _____	T _____	R _____
3. Miscellaneous Property in Sec.	S _____	T _____	R _____
	S _____	T _____	R _____

Register of Deeds Stamp & File Number

4. Lot No. _____, Recorded Plat _____
 5. Private Claims _____

	A	B	C	D	E	F	G	H	I	J	K	L	M
2	6	5	4	3	2	1							
3													
4	7	8	9	10	11	12							
5													
6	18	17	16	15	14	13							
7													
8	19	20	21	22	23	24							
9													
10	30	29	28	27	26	25							
11													
12	31	32	33	34	35	36							
13													

I, Daniel E. Johnson, in a field survey on May 23, 1995, do hereby certify that under requirements of P.A. 74, Michigan P.A. of 1970, the corner points mentioned in lines 1 and 2 above were in conformance with regulations and rules therefore as required in the current manual of survey instructions of the United States Department of the Interior, Bureau of Land Management or by a decree of a Court of Law and/or that the corner points mentioned in lines 3, 4 and 5 above were in conformance with the rules of the Michigan Board of Land Surveyors or by a Decree of a Court of Law; established, re-established, monumented, re-monumented, recovered, found as expressed below:

NOTE: Not more than 1 corner, may be recorded on this certificate.

A. Description of original monument and accessories and/or subsequent restoration:

LIBER 007 PAGE 299

STATE PLAIN COORDINATES


N. _____

E. _____

ELEVATION _____

B. Description of corner evidence found and/or method applied in restoring or reestablishing corner:

LIBER 007 PAGE 299

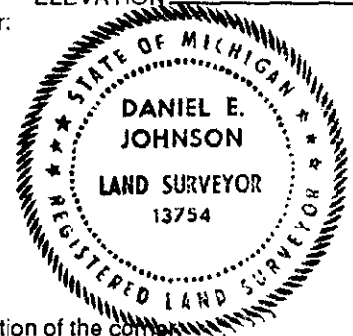

C. Description of monument for corner and accessories established to perpetuate locating the position of the corner:
 Set 2" Dia. Aluminum Cap inscribed "St. Clair County Official Corner" with magnet over "T" Iron in Monument box.
 (1.76' South of line between section corners, S $\frac{1}{4}$ 31, SE 31, T.7N., R.14E.)
 25.7' SW to set P.K. and County Tag in top Guard Rail Post (near F. Spike)
 35.65' SE to set P.K. and County Tag in top Guard Rail Post (near F. Spike)
 25.5' NE to set P.K. and County Tag in top Guard Rail Post (near F. Spike)
 27.5' NW to set P.K. and County Tag in top Guard Rail Post (near F. Spike)

Signed by Daniel E. Johnson Date May 23, 1995
 Daniel E. Johnson

Surveyor's Michigan License No. 13754

PA 345-1990
PEER COMMITTEE

APPROVED AS AN OFFICIAL GOVERNMENT CORNER BY ST. CLAIR COUNTY:
 Signed By: Daniel E. Johnson : 7/25/95
 St. Clair County Land Surveyor Daniel E. Johnson Date
 13754

APPROVED 6-17-94
 LIBER 008 PAGE 183

Surveyor's Michigan License No. _____