

ST. CLAIR COUNTY, MICHIGAN OFFICIAL GOVERNMENT CORNER



LAND CORNER RECORDATION CERTIFICATE Filing Requirement of Act 74, Mich. P.A. 1970

	Located In:	Corner Code #
1. Public Land Survey	T <u>6N</u> R <u>14E</u>	<u>L-1</u>
	T _____ R _____	_____
	T _____ R _____	_____
	T _____ R _____	_____
2. Property Controlling in Section	S _____ T _____ R _____	<u>Seg #2</u>
	S _____ T _____ R _____	_____
3. Miscellaneous Property in Sec.	S _____ T _____ R _____	_____
	S _____ T _____ R _____	_____

REGISTERED
 ST. CLAIR COUNTY
 1995 MAR -4 AM 10:23
 Register of Deeds Stamp & File Number

4. Lot No. _____, Recorded Plat _____

5. Private Claims _____

	A	B	C	D	E	F	G	H	I	J	K	L
2	6	5	4	3	2	1						
3												
4	7	8	9	10	11	12						
5												
6	13	17	16	15	14	13						
7												
8	19	20	21	22	23	24						
9												
10	30	29	28	27	26	25						
11												
12	31	32	33	34	35	36						
13												

I, Daniel E. Johnson field survey on March 3, 1994 do hereby certify that under requirements of P.A. 74, Michigan P.A. of 1970, the corner points mentioned in lines 1 and 2 above were in conformance with regulations and rules therefore as required in the current manual of survey instructions of the United States Department of the Interior, Bureau of Land Management or by a decree of a Court of Law and/or that the corner points mentioned in lines 3, 4 and 5 above were in conformance with the rules of the Michigan Board of Land Surveyors or by a Decree of a Court of Law; established, re-established, monumented, re-monumented, recovered, found as expressed below:

NOTE: Not more than 1 corner, may be recorded on this certificate.

A. Description of original monument and accessories and/or subsequent restoration:

LIBER 007 PAGE 279

STATE PLAIN COORDINATES


N. _____

E. _____

B. Description of corner evidence found and/or method applied in restoring or reestablishing corner:

LIBER 007 PAGE 279

ELEVATION _____

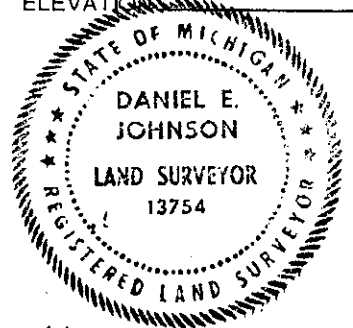

C. Description of monument for corner and accessories established to perpetuate locating the position of the corner:

"ACCEPTED MICHIGAN DEPARTMENT OF TRANSPORTATION BRASS DISC"

5/8" Rod with 1 1/2" disc. (4.32' North to line between section corners SE 36, S 1/4 36, T.7N., R.14E.)

- 23.40' NW to set P.K. and County Tag in 18" Elm.
- 62.50' S to set P.K. and County Tag in 15" Elm.
- 21.38' N to set P.K. and County Tag in 12" Elm.
- 3.87' E to set P.K. and County Tag in 12" Elm.

Signed by Daniel E. Johnson Date March 3, 1994
 Daniel E. Johnson
 Surveyor's Michigan License No. 13754

PA 345-1990
PEER COMMITTEE

APPROVED 6-17-94

APPROVED AS AN OFFICIAL GOVERNMENT CORNER BY ST. CLAIR COUNTY:

Signed By: Daniel E. Johnson Date 7-25-95
 St. Clair County Land Surveyor Daniel E. Johnson
 13754

LIBER 008 PAGE 173