

# ST. CLAIR COUNTY, MICHIGAN OFFICIAL GOVERNMENT CORNER



## LAND CORNER RECORDATION CERTIFICATE Filing Requirement of Act 74, Mich. P.A. 1970

	Located In:	Corner Code ##
1. Public Land Survey	T <u>6N</u> R <u>14E</u>	<u>G-1</u>
	T _____ R _____	_____
	T _____ R _____	_____
	T _____ R _____	_____
2. Property Controlling in Section	S _____ T _____ R _____	<u>Seg. #2</u>
	S _____ T _____ R _____	_____
3. Miscellaneous Property in Sec.	S _____ T _____ R _____	_____
	S _____ T _____ R _____	_____

REGISTERED LAND SURVEYOR  
 DANIEL E. JOHNSON  
 13754  
 MICHIGAN  
 7-25-95

Register of Deeds Stamp & File Number

4. Lot No. \_\_\_\_\_, Recorded Plat \_\_\_\_\_  
 5. Private Claims \_\_\_\_\_

	A	B	C	D	E	F	G	H	I	J	K	L	I
2	6	5	4	3	2	1							
3													
4	7	8	9	10	11	12							
5													
6	18	17	16	15	14	13							
7													
8	19	20	21	22	23	24							
9													
10	30	29	28	27	26	25							
11													
12	31	32	33	34	35	36							
13													

I, Daniel E. Johnson, in a field survey on March 9, 19 94, do hereby certify that under requirements of P.A. 74, Michigan P.A. of 1970, the corner points mentioned in lines 1 and 2 above were in conformance with regulations and rules therefore as required in the current manual of survey instructions of the United States Department of the Interior, Bureau of Land Management or by a decree of a Court of Law and/or that the corner points mentioned in lines 3, 4 and 5 above were in conformance with the rules of the Michigan Board of Land Surveyors or by a Decree of a Court of Law; established, re-established, monumented, re-monumented, recovered, found as expressed below:

**NOTE: Not more than 1 corner, may be recorded on this certificate.**

A. Description of original monument and accessories and/or subsequent restoration:


LIBER 007 PAGE 289

STATE PLAIN COORDINATES

N. \_\_\_\_\_  
 E. \_\_\_\_\_

B. Description of corner evidence found and/or method applied in restoring or reestablishing corner:

LIBER 007 PAGE 289

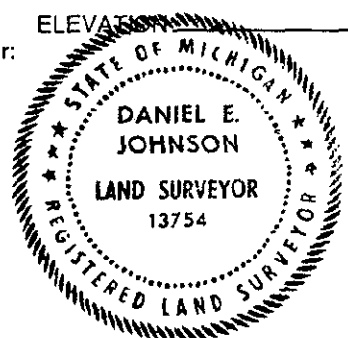

C. Description of monument for corner and accessories established to perpetuate locating the position of the corner:

"ACCEPTED MICHIGAN DEPARTMENT OF TRANSPORTATION BRASS DISC"  
 5/8" bar with 1 1/2" brass disc. (1.20' North to line between section corners, SW 34, S 1/4 34, T.7N., R.14E.)  
 74.51' SE to set P.K. and County Tag in P.Pole.  
 207.63' SSE to set P.K. and County Tag in 30" Tree.  
 385.06' ESE to set P.K. and County Tag in P.Pole.  
 361.88' WSW to set P.K. and County Tag in Tele Pole.  
 1" Iron pin 0.1'W & 0.05'S. & 0.15' above brass disk.

Signed by Daniel E. Johnson Date March 9, 1994  
 Daniel E. Johnson  
 Surveyor's Michigan License No. 13754

PA 345-1990  
 PEER COMMITTEE  
 APPROVED 6-17-94  
Dans

APPROVED AS AN OFFICIAL GOVERNMENT CORNER BY ST. CLAIR COUNTY:

Signed By: Daniel E. Johnson  
 St. Clair County Land Surveyor Daniel E. Johnson  
 13754  
 Surveyor's Michigan License No. \_\_\_\_\_

Date 7-25-95  
 LIBER 008 PAGE 178