

ST. CLAIR COUNTY, MICHIGAN OFFICIAL GOVERNMENT CORNER



LAND CORNER RECORDATION CERTIFICATE Filing Requirement of Act 74, Mich. P.A. 1970

	Located In:	Corner Code ##
1. Public Land Survey	T <u>6N</u> R <u>14E</u>	<u>F-1</u>
	T _____ R _____	_____
	T _____ R _____	_____
	T _____ R _____	_____
2. Property Controlling in Section	S _____ T _____ R _____	<u>Seg #2</u>
	S _____ T _____ R _____	_____
3. Miscellaneous Property in Sec.	S _____ T _____ R _____	_____
	S _____ T _____ R _____	_____

REGISTER OF DEEDS STAMP & FILE NUMBER

MICHIGAN DEPARTMENT OF STATE

RECORDS SECTION

MAY 10 1994

4. Lot No. _____, Recorded Plat _____
 5. Private Claims _____

	A	B	C	D	E	F	G	H	I	J	K	L	I
2	6		5		4		3		2		1		
3													
4	7		8		9		10		11		12		
5													
6	18		17		16		15		14		13		
7													
8	19		20		21		22		23		24		
9													
10	30		29		28		27		26		25		
11													
12	31		32		33		34		35		36		
13													

I, Daniel E. Johnson in a field survey on March 9, 19 94 do hereby certify that under requirements of P.A. 74, Michigan P.A. of 1970, the corner points mentioned in lines 1 and 2 above were in conformance with regulations and rules therefore as required in the current manual of survey instructions of the United States Department of the Interior, Bureau of Land Management or by a decree of a Court of Law and/or that the corner points mentioned in lines 3, 4 and 5 above were in conformance with the rules of the Michigan Board of Land Surveyors or by a Decree of a Court of Law; established, re-established, monumented, re-monumented, recovered, found as expressed below:

NOTE: Not more than 1 corner, may be recorded on this certificate.

A. Description of original monument and accessories and/or subsequent restoration:

LIBER 007 PAGE 291

STATE PLAIN COORDINATES


N. _____

E. _____

B. Description of corner evidence found and/or method applied in restoring or reestablishing corner:

LIBER 007 PAGE 291

ELEVATION _____

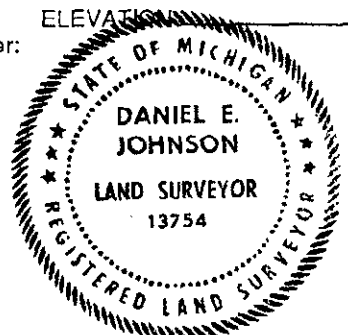

C. Description of monument for corner and accessories established to perpetuate locating the position of the corner:

"ACCEPTED MICHIGAN DEPARTMENT OF TRANSPORTATION BRASS DISC.
 5/8" Rod with 1 1/2" brass disc. (4.76' South to line between section corner
 S $\frac{1}{4}$ 33, SE 33, T.7N., R.14E.)
 53.57' SSW to set P.K. and County Tag in P. Pole.
 59.59' SW to set P.K. and County Tag in 4" Poplar
 175.15' NW to set P.K. and County Tag in 12" Tree
 405.54' ESE to set P.K. and County Tag in P. Pole.

Signed by Daniel E. Johnson Date March 9, 1994

Surveyor's Michigan License No. 13754

PA 345-1990
 PEER COMMITTEE
 APPROVED 6-17-94 *Davis*

APPROVED AS AN OFFICIAL GOVERNMENT CORNER BY ST. CLAIR COUNTY:

Signed By: Daniel E. Johnson
 St. Clair County Land Surveyor Daniel E. Johnson

7/25/95
 Date

Surveyor's Michigan License No. 13754

LIBER 008 PAGE 179