

ST. CLAIR COUNTY, MICHIGAN OFFICIAL GOVERNMENT CORNER



LAND CORNER RECORDATION CERTIFICATE Filing Requirement of Act 74, Mich. P.A. 1970

	Located In:	Corner Code #
	Wales Twp.	
1. Public Land Survey	6N 15E	E-1
	T _____ R _____	_____
	T _____ R _____	_____
	T _____ R _____	_____
	T _____ R _____	_____
2. Property Controlling in Section	S _____ T _____ R _____	<i>Seg. 2</i>
	S _____ T _____ R _____	_____
3. Miscellaneous Property in Sec.	S _____ T _____ R _____	_____
	S _____ T _____ R _____	_____

RECEIVED
1995 AUG -4 AM 10:48
Register of Deeds Stamp & File Number

4. Lot No. _____, Recorded Plat _____
5. Private Claims _____

I, Daniel E. Johnson in a field survey on April 17, 1995
do hereby certify that under requirements of P.A. 74, Michigan P.A. of 1970, the corner points mentioned in lines 1 and 2 above were in conformance with regulations and rules therefore as required in the current manual of survey instructions of the United States Department of the Interior, Bureau of Land Management or by a decree of a Court of Law and/or that the corner points mentioned in lines 3, 4 and 5 above were in conformance with the rules of the Michigan Board of Land Surveyors or by a Decree of a Court of Law, established, re-established, monumented, re-monumented, recovered, found as expressed below:

	A	B	C	D	E	F	G	H	I	J	K	L	M
2	6	5	4	3	2								
3													
4	7	8	9	10	11	12							
5													
6	18	17	16	15	14	13							
7													
8	19	20	21	22	23	24							
9													
10	30	29	28	27	26	25							
11													
12	31	32	33	34	35	36							
13													

NOTE: Not more than 1 corner, may be recorded on this certificate.

A. Description of original monument and accessories and/or subsequent restoration:


LIBER 007 PAGE 169

STATE PLAIN COORDINATES

N. _____
E. _____

B. Description of corner evidence found and/or method applied in restoring or reestablishing corner:

LIBER 007 PAGE 169

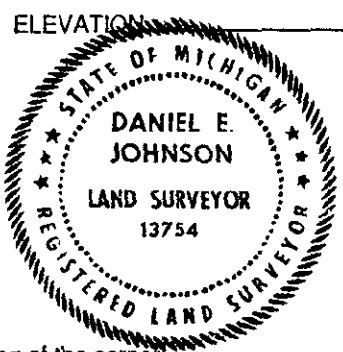

C. Description of monument for corner and accessories established to perpetuate locating the position of the corner:
Set a 2" dia. aluminum cap inscribed "St. Clair County Official Corner" with magnet on a "T" iron.
SE 96.28' to set PK and County Tag in N face of 15" Maple.
NE 143.0' to set PK and County Tag in S face of 24" Maple.
NNW 231.70' to base of D.E. High Tension Power Line Tower leg set in conc.

Signed by *Daniel E. Johnson* Date April 17, 1995
Daniel E. Johnson 13754
Surveyor's Michigan License No. _____

PA 345-1990
PEER COMMITTEE
APPROVED 12-14-93 *Dub*

APPROVED AS AN OFFICIAL GOVERNMENT CORNER BY ST. CLAIR COUNTY:
Signed By: *Daniel E. Johnson* : 7-31-95
St. Clair County Land Surveyor Daniel E. Johnson
13754
Surveyor's Michigan License No. _____