

# ST. CLAIR COUNTY, MICHIGAN OFFICIAL GOVERNMENT CORNER



## LAND CORNER RECORDATION CERTIFICATE Filing Requirement of Act 74, Mich. P.A. 1970

	Located In:	Corner Code #	
1. Public Land Survey	T <u>6N</u> R <u>15E</u>	<u>J-1</u>	
	T _____ R _____	_____	
	T _____ R _____	_____	
	T _____ R _____	_____	
2. Property Controlling in Section	S _____ T _____ R _____	<u>Seg-1</u>	
	S _____ T _____ R _____	_____	
3. Miscellaneous Property in Sec.	S _____ T _____ R _____	_____	
	S _____ T _____ R _____	_____	
4. Lot No. _____, Recorded Plat _____			
5. Private Claims _____			

RECEIVED  
 1993 DEC 29 AM 9:08  
 REGISTER OF DEEDS STAMPS & FILE NUMBER

I, David J. Little, in a field survey on October 7, 1993, do hereby certify that under requirements of P.A. 74, Michigan P.A. of 1970, the corner points mentioned in lines 1 and 2 above were in conformance with regulations and rules therefore as required in the current manual of survey instructions of the United States Department of the Interior, Bureau of Land Management or by a decree of a Court of Law and/or that the corner points mentioned in lines 3, 4 and 5 above were in conformance with the rules of the Michigan Board of Land Surveyors or by a Decree of a Court of Law; established, re-established, monumented, re-monumented, recovered, found as expressed below:

	A	B	C	D	E	F	G	H	I	J	K	L	M
2	6	5	4	3	2								
3													
4	7	8	9	10	11	12							
5													
6	18	17	16	15	14	13							
7													
8	19	20	21	22	23	24							
9													
10	30	29	28	27	26	25							
11													
12	31	32	33	34	35	36							
13													

**NOTE: Not more than 1 corner, may be recorded on this certificate.**

A. Description of original monument and accessories and/or subsequent restoration:

**This corner not set in Government Surveys.**

**Corner not identified on Old Surveyor's Record St. Clair County.**

**Corner recorded in L.4 P.313 of recordations certificates.**

B. Description of corner evidence found and/or method applied in restoring or reestablishing corners:

**Found Iron in Monument Box.**

**Corner varified by 1930 Michigan State Highway Department Plans.**

2159A000 12/29/93KSSU4 9.00  
\*\*0001\*\*

2159A000 12/29/93SSRE4 2.00  
\*\*0001\*\*


**Corner on line with the S. 1/4 corner Section 35 T7N, R15E and the SE corner Section 35 T7N, R15E.**

C. Description of monument for corner and accessories established to perpetuate locating the position of the corner:

**Iron in Monument Box.**

**N. 50.73' to set P.K. and County Tag in E. face of utility pole  
SE 94.70' to set P.K. and County Tag in NW face of D.E.P.  
NE 186.57' to set P.K. and County Tag in SE face of utility pole  
(Corner is on centerline of existing Lapeer Road pavement)**

**See attached sketch for additional information.**

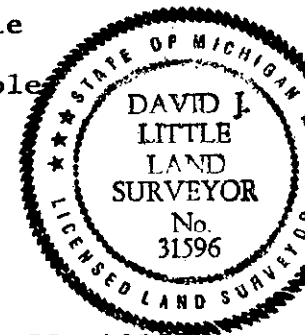

Signed by David J. Little  
Surveyor's Michigan License No. 31596

Date November 20, 1993

APPROVED AS AN OFFICIAL GOVERNMENT CORNER BY ST. CLAIR COUNTY:

PA 345-1990  
 PEER COMMITTEE  
 APPROVED 12-7-93

Signed By: \_\_\_\_\_ Date \_\_\_\_\_  
St. Clair County Land Surveyor