

ST. CLAIR COUNTY, MICHIGAN OFFICIAL GOVERNMENT CORNER



LAND CORNER RECORDATION CERTIFICATE Filing Requirement of Act 74, Mich. P.A. 1970

RECEIVED
ST. CLAIR COUNTY REGISTER OF DEEDS
JUN 24 11 10:26 AM '95

	Located In:	Corner Code #
	Wales Twp.	
1. Public Land Survey	T <u>6N.</u> R <u>R15E.</u>	<u>M-2</u>
	T _____ R _____	_____
	T _____ R _____	_____
	T _____ R _____	_____
	T _____ R _____	_____
2. Property Controlling in Section	S _____ T _____ R _____	<u>Sec 2</u>
	S _____ T _____ R _____	_____
3. Miscellaneous Property in Sec.	S _____ T _____ R _____	_____
	S _____ T _____ R _____	_____

Register of Deeds Stamp & File Number

4. Lot No. _____, Recorded Plat _____
5. Private Claims _____

	A	B	C	D	E	F	G	H	I	J	K	L	M
2	6	5	4	3	2	1							
3													
4	7	8	9	10	11	12							
5													
6	18	17	16	15	14	13							
7													
8	19	20	21	22	23	24							
9													
10	30	29	28	27	26	25							
11													
12	31	32	33	34	35	36							
13													

I, Daniel E. Johnson, in a field survey on June 24, 1995, do hereby certify that under requirements of P.A. 74, Michigan P.A. of 1970, the corner points mentioned in lines 1 and 2 above were in conformance with regulations and rules therefore as required in the current manual of survey instructions of the United States Department of the Interior, Bureau of Land Management or by a decree of a Court of Law and/or that the corner points mentioned in lines 3, 4 and 5 above were in conformance with the rules of the Michigan Board of Land Surveyors or by a Decree of a Court of Law; established, re-established, monumented, re-monumented, recovered, found as expressed below:

NOTE: Not more than 1 corner, may be recorded on this certificate.

A. Description of original monument and accessories and/or subsequent restoration:

LIBER 007 PAGE 388

STATE PLAIN COORDINATES


N. _____

E. _____

ELEVATION _____

B. Description of corner evidence found and/or method applied in restoring or reestablishing corner:

LIBER 007 PAGE 388

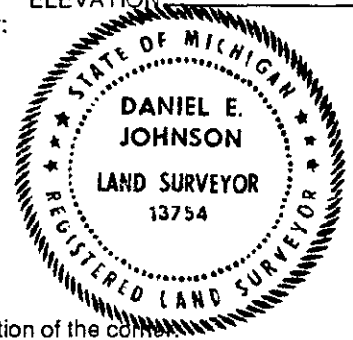

C. Description of monument for corner and accessories established to perpetuate locating the position of the corner:
Set 2" dia. aluminum cap inscribed "St Clair County Official Corner" with magnet on a Capped 1/2" rerod #24608. Located on the True Township line.
 SSE 3.11' to set PK nail w/county remon tag in W side 12" Ash tree
 WSW 15.59' to set PK nail w/county remon tag in N side 18" Ash tree
 N. 18.04' to set PK nail w/county remon tag in W side 15" Ash tree
 S. 49.78' to set PK nail w/county remon tag in W side 24" Ash tree
 N. 2699.51' to N.E. corner of Section 1, T6N-R15E
 S. 2688.45' to S.E. corner of Section 1, T6N-R15E

Signed by Daniel E. Johnson Date June 24, 1995

Surveyor's Michigan License No. 13754

PA 345-1990
PEER COMMITTEE

APPROVED 6-24-94

APPROVED AS AN OFFICIAL GOVERNMENT CORNER BY ST. CLAIR COUNTY:

Signed By: Daniel E. Johnson : 7/31/95
St. Clair County Land Surveyor Daniel E. Johnson Date

Surveyor's Michigan License No. 13754

LIBER 008 PAGE 197