

# ST. CLAIR COUNTY, MICHIGAN OFFICIAL GOVERNMENT CORNER



## LAND CORNER RECORDATION CERTIFICATE Filing Requirement of Act 74, Mich. P.A. 1970

	Located In:	Corner Code #
	Wales Twp.	
1. Public Land Survey	T <u>6N</u> R <u>15E</u> .	<u>M-3</u>
	T _____ R _____	_____
	T _____ R _____	_____
	T _____ R _____	_____
2. Property Controlling in Section	S _____ T _____ R _____	<i>Seg. 1</i>
	S _____ T _____ R _____	
	S _____ T _____ R _____	
3. Miscellaneous Property in Sec.	S _____ T _____ R _____	_____
	S _____ T _____ R _____	_____
4. Lot No. _____, Recorded Plat _____		
5. Private Claims _____		

REGISTERED DEEDS  
 ST. CLAIR COUNTY  
 RECEIVED  
 1993 DEC 29 AM 9:03  
 Register of Deeds Stamp & File Number

	A	B	C	D	E	F	G	H	I	J	K	L	M
2	6	5	4	3	2	1							
3													
4	7	8	9	10	11	12							
5													
6	18	17	16	15	14	13							
7													
8	19	20	21	22	23	24							
9													
10	30	29	28	27	26	25							
11													
12	31	32	33	34	35	36							
13													

I, John R. Lansky, in a field survey on Sept. 27-Oct 1, 1993  
 do hereby certify that under requirements of P.A. 74, Michigan P.A. of 1970, the corner points mentioned in lines 1 and 2 above were in conformance with regulations and rules therefore as required in the current manual of survey instructions of the United States Department of the Interior, Bureau of Land Management or by a decree of a Court of Law and/or that the corner points mentioned in lines 3, 4 and 5 above were in conformance with the rules of the Michigan Board of Land Surveyors or by a Decree of a Court of Law; established, re-established, monumented, re-monumented, recovered, found as expressed below:

**NOTE: Not more than 1 corner, may be recorded on this certificate.**

- A. Description of original monument and accessories and/or subsequent restoration:
1. 14" Beech-- Original Gov't Survey.
  2. Ford Axle - Per Old Surveyor's Rec. St. Clair Co.
  3. 3/4" Iron Pipe-- Per Certificate L.3 P.416
- B. Description of corner evidence found and/or method applied in restoring or reestablishing corner:  
 Found 3/4" Iron Pipe at Fence Interseciton  
 Fence line to West and Fence Line North & South.

STATE PLAIN COORDINATES

N. \_\_\_\_\_

E. \_\_\_\_\_


ELEVATION \_\_\_\_\_

C. Description of monument for corner and accessories established to perpetuate locating the position of the corner:  
3/4" Iron Pipe (Old)

- N.N.W. 7.85 ft. Set PK nail & tag in 24" Oak
- Southerly 18.35 ft. Set PK Nail & tag in 18" Black Cherry
- N.E.'ly 28.00 ft. Set PK Nail & Tag in 12" Oak
- Southerly 25.70 to Iron at N.W. Corner of Sec. 7, T.6N., R.16E.,

See attached sketch for additional information.

2159A000 12/29/93KSSU4 9.00  
 \*\*000J\*\*  
 2159A000 12/29/93SSRF4 2.00  
 \*\*000J\*\*

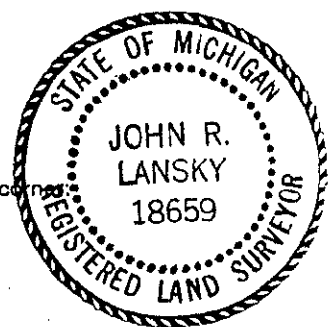

Signed by *John R. Lansky* Date Oct. 6, 1993  
 Surveyor's Michigan License No. 18659

PA 345-1990  
 PEER COMMITTEE  
 APPROVED 11-23-93

APPROVED AS AN OFFICIAL GOVERNMENT CORNER BY ST. CLAIR COUNTY:

Signed By: \_\_\_\_\_ Date: \_\_\_\_\_  
 St. Clair County Land Surveyor

Surveyor's Michigan License No. \_\_\_\_\_