

ST. CLAIR COUNTY, MICHIGAN OFFICIAL GOVERNMENT CORNER



LAND CORNER RECORDATION CERTIFICATE Filing Requirement of Act 74, Mich. P.A. 1970

RECEIVED
 REGISTERED LAND SURVEYORS
 ST. CLAIR COUNTY
 5 AUG -4 AM 10:25

	Located In:	Corner Code #/
	Wales Twp.	
1. Public Land Survey	T <u>6N.</u> R <u>15E.</u>	<u>M-5</u>
	T _____ R _____	_____
	T _____ R _____	_____
	T _____ R _____	_____
2. Property Controlling in Section	S _____ T _____ R _____	<u>Sec. 2</u>
	S _____ T _____ R _____	_____
3. Miscellaneous Property in Sec.	S _____ T _____ R _____	_____
	S _____ T _____ R _____	_____

Register of Deeds Stamp & File Number

4. Lot No. _____, Recorded Plat _____
5. Private Claims _____

	A	B	C	D	E	F	G	H	I	J	K	L	M
2	6	5	4	3	2	1							
3													
4	7	8	9	10	11	12							
5													
6	18	17	16	15	14	13							
7													
8	19	20	21	22	23	24							
9													
10	30	29	28	27	26	25							
11													
12	31	32	33	34	35	36							
13													

Daniel E. Johnson **June 23,** **95**

I, _____, in a field survey on _____, 19____, do hereby certify that under requirements of P.A. 74, Michigan P.A. of 1970, the corner points mentioned in lines 1 and 2 above were in conformance with regulations and rules therefore as required in the current manual of survey instructions of the United States Department of the Interior, Bureau of Land Management or by a decree of a Court of Law and/or that the corner points mentioned in lines 3, 4 and 5 above were in conformance with the rules of the Michigan Board of Land Surveyors or by a Decree of a Court of Law, established, re-established, monumented, re-monumented, recovered, found as expressed below:

NOTE: Not more than 1 corner, may be recorded on this certificate.

A. Description of original monument and accessories and/or subsequent restoration:

LIBER 007 PAGE 122

STATE PLAIN COORDINATES


N. _____

E. _____

B. Description of corner evidence found and/or method applied in restoring or reestablishing corner:

LIBER 007 PAGE 122

ELEVATION _____

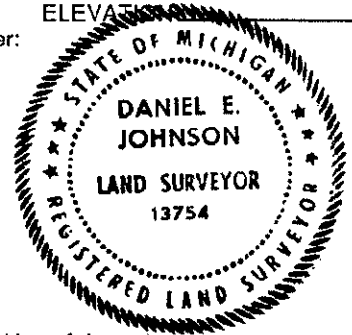

C. Description of monument for corner and accessories established to perpetuate locating the position of the corner:

Set 2" dia. aluminum cap inscribed "St Clair County Official Corner" with magnet on an Iron Rod with Cap RLS 19835
N.E. 42.53 ft. Set PK Nail and Tag in 8" Elm
S.E. 57.15 ft. Set PK Nail and Tag in 12" Elm
S.W. 137.05 ft. found spike/Cap RLS 18659 in D.E. Pole S'ly 57.94 ft. to S.W. Cor. Sec. 7, T.6N., R.16E.

Signed by 1995 *Daniel E. Johnson* Date June 23, 1995

Daniel E. Johnson
 Surveyor's Michigan License No. 13754

PA 345-1990
 PEER COMMITTEE

APPROVED 11-23-93

APPROVED AS AN OFFICIAL GOVERNMENT CORNER BY ST. CLAIR COUNTY:

Signed By: *Daniel E. Johnson* Date 7-31-95

St. Clair County Land Surveyor Daniel E. Johnson Date

Surveyor's Michigan License No. 13754