

ST. CLAIR COUNTY, MICHIGAN OFFICIAL GOVERNMENT CORNER



LAND CORNER RECORDATION CERTIFICATE
Filing Requirement of Act 74, Mich. P.A. 1970

Located In: Wales Twp. Corner Code # M-6

1. Public Land Survey	T <u>6N.</u> R <u>15E.</u>	<u>M-6</u>
	T _____ R _____	_____
	T _____ R _____	_____
	T _____ R _____	_____
2. Property Controlling in Section	S _____ T _____ R _____	<u>Seg-1</u>
	S _____ T _____ R _____	_____
3. Miscellaneous Property in Sec.	S _____ T _____ R _____	_____
	S _____ T _____ R _____	_____

REGISTERED
ST. CLAIR COUNTY
1993 DEC 29 AM 9:02
RECEIVED
Register of Deeds Stamp & File Number

4. Lot No. _____, Recorded Plat _____
5. Private Claims _____

I, John R. Lansky, in a field survey on Sept. 20-24, 1993 do hereby certify that under requirements of P.A. 74, Michigan P.A. of 1970, the corner points mentioned in lines 1 and 2 above were in conformance with regulations and rules therefore as required in the current manual of survey instructions of the United States Department of the Interior, Bureau of Land Management or by a decree of a Court of Law and/or that the corner points mentioned in lines 3, 4 and 5 above were in conformance with the rules of the Michigan Board of Land Surveyors or by a Decree of a Court of Law; established, re-established, monumented, re-monumented, recovered, found as expressed below:

	A	B	C	D	E	F	G	H	I	J	K	L	M
2	6	5	4	3	2	1							
3													
4	7	8	9	10	11	12							
5													
6	18	17	16	15	14	13							
7													
8	19	20	21	22	23	24							
9													
10	30	29	28	27	26	25							
11													
12	31	32	33	34	35	36							
13													

NOTE: Not more than 1 corner, may be recorded on this certificate.

- A. Description of original monument and accessories and/or subsequent restoration:
1. 4" Beech-- Per Original Gov't Survey
 2. Stone Per Old Surveyor's Rec. St. Clair Co.
 3. Stone Per Certificate L.2 P.147

STATE PLAIN COORDINATES

N. _____

E. _____

ELEVATION _____


- B. Description of corner evidence found and/or method applied in restoring or reestablishing corner:
- Found Large Spike over Stone**

2159A000 12/29/93MSSU4 9.00
0001

2159A000 12/29/93SSRE4 2.00
0001

- C. Description of monument for corner and accessories established to perpetuate locating the position of the corner:

Large Spike over Stone
S.W. 33.33 set PK nail & tag in 30" Locust
S.W. 148.70 ft. Set PK Nail & Tag in D.E. Pole
S.E. 142.35 ft. " " " in 15" Maple

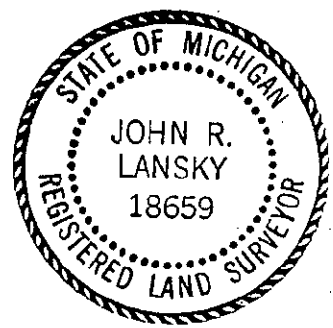

See attached sketch for additional information.

Signed by John R. Lansky Date Sept. 29, 1993
Surveyor's Michigan License No. 18659

PA 345-1990
PEER COMMITTEE
APPROVED 11-23-93

APPROVED AS AN OFFICIAL GOVERNMENT CORNER BY ST. CLAIR COUNTY:
Signed By: _____ Date _____
St. Clair County Land Surveyor