

ST. CLAIR COUNTY, MICHIGAN OFFICIAL GOVERNMENT CORNER



LAND CORNER RECORDATION CERTIFICATE Filing Requirement of Act 74, Mich. P.A. 1970

	Located In:	Corner Code #	
	Wales Twp.		
1. Public Land Survey	T <u>6N</u> R <u>15E</u>	<u>M-8</u>	
	T _____ R _____	_____	
	T _____ R _____	_____	
	T _____ R _____	_____	
2. Property Controlling in Section	S _____ T _____ R _____	<u>Sec. 2</u>	
	S _____ T _____ R _____	_____	
3. Miscellaneous Property in Sec.	S _____ T _____ R _____	_____	
	S _____ T _____ R _____	_____	
4. Lot No. _____, Recorded Plat _____			
5. Private Claims _____			

RECEIVED
REGISTER OF DEEDS
MAY 11 1995 4 11 10:2
Register of Deeds Stamp & File Number

I, Daniel E. Johnson, in a field survey on May 11, 1995, do hereby certify that under requirements of P.A. 74, Michigan P.A. of 1970, the corner points mentioned in lines 1 and 2 above were in conformance with regulations and rules therefore as required in the current manual of survey instructions of the United States Department of the Interior, Bureau of Land Management or by a decree of a Court of Law and/or that the corner points mentioned in lines 3, 4 and 5 above were in conformance with the rules of the Michigan Board of Land Surveyors or by a Decree of a Court of Law, established, re-established, monumented, re-monumented, recovered, found as expressed below:

	A	B	C	D	E	F	G	H	I	J	K	L	M
2	6	5	4	3	2	1							
3													
4	7	8	9	10	11	12							
5													
6	18	17	16	15	14	13							
7													
8	19	20	21	22	23	24							
9													
10	30	29	28	27	26	25							
11													
12	31	32	33	34	35	36							
13													

NOTE: Not more than 1 corner, may be recorded on this certificate.

A. Description of original monument and accessories and/or subsequent restoration:

SEE LIBER 007 PAGE 108


STATE PLAIN COORDINATES

N. _____

E. _____

B. Description of corner evidence found and/or method applied in restoring or reestablishing corner:

SEE LIBER 007 PAGE 108

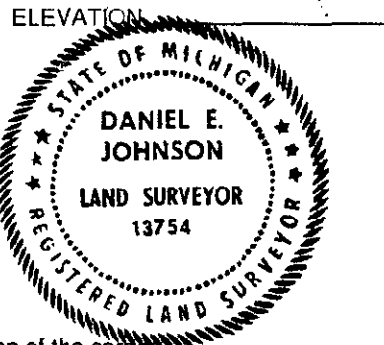

C. Description of monument for corner and accessories established to perpetuate locating the position of the corner:

Set a 2" dia. aluminum cap inscribed "St. Clair County Official Corner" with magnet on an approx. 1 1/2" dia. iron pipe.
 N.E. 37.47 ft. Set PK Nail and tag in 15" Elm.
 W.N.W. 29.45 ft. Set PK Nail and tag in 36" Maple.
 S'y 43.00 ft. to west 1/4 corner, Section 19, T.6N., R.16E.
 S.E. 51.96 ft. ste PK Nail and tag in guy pole.

Signed by Daniel E. Johnson Date May 11, 1995
 Daniel E. Johnson

Surveyor's Michigan License No. 13754

PA 345-1990
PEER COMMITTEE

APPROVED 11-16-93

APPROVED AS AN OFFICIAL GOVERNMENT CORNER BY ST. CLAIR COUNTY:

Signed By: Daniel E. Johnson Date 7-31-95
 St. Clair County Land Surveyor Daniel E. Johnson

Surveyor's Michigan License No. 13754