

**ST. CLAIR COUNTY, MICHIGAN
OFFICIAL GOVERNMENT CORNER**



**LAND CORNER RECORDATION CERTIFICATE
Filing Requirement of Act 74, Mich. P.A. 1970**

	Located In:	Corner Code #
	Wales Twp.	
1. Public Land Survey	T <u>6N</u> R <u>15E.</u>	<u>M-10</u>
	T _____ R _____	_____
	T _____ R _____	_____
	T _____ R _____	_____
2. Property Controlling in Section	S _____ T _____ R _____	<u>Seg. 1</u>
	S _____ T _____ R _____	_____
3. Miscellaneous Property in Sec.	S _____ T _____ R _____	_____
	S _____ T _____ R _____	_____

RECEIVED
 REGISTER OF DEEDS
 ST. CLAIR COUNTY
 1993 DEC 29 AM 9:00
 Register of Deeds Stamp & File Number

4. Lot No. _____, Recorded Plat _____
 5. Private Claims _____

I, John R. Lansky, in a field survey on Sept 20, 1993, do hereby certify that under requirements of P.A. 74, Michigan P.A. of 1970, the corner points mentioned in lines 1 and 2 above were in conformance with regulations and rules therefore as required in the current manual of survey instructions of the United States Department of the Interior, Bureau of Land Management or by a decree of a Court of Law and/or that the corner points mentioned in lines 3, 4 and 5 above were in conformance with the rules of the Michigan Board of Land Surveyors or by a Decree of a Court of Law, established, re-established, monumented, re-monumented, recovered, found as expressed below:

A	B	C	D	E	F	G	H	I	J	K	L	M
2	6	5	4	3	2	1						
3												
4	7	8	9	10	11	12						
5												
6	18	17	16	15	14	13						
7												
8	19	20	21	22	23	24						
9												
10	30	29	28	27	26	25						
11												
12	31	32	33	34	35	36						
13												

NOTE: Not more than 1 corner, may be recorded on this certificate.

A. Description of original monument and accessories and/or subsequent restoration:

1. Post-- Original Gov't Survey
2. Nothing Listed on Old Surveyor's Rec. For St. Clair County.
3. Found Old Pinch Top Iron Pipe, (Replaced with "T" Iron)

STATE PLAIN COORDINATES

N. _____
 E. _____
 ELEVATION _____

B. Description of corner evidence found and/or method applied in restoring or reestablishing corner:

Found Old Pinch Top Iron Pipe (Replaced with "T" Iron)

Pipe was shown on recorded surveys but no certificate has been filed for this location to date.

C. Description of monument for corner and accessories established to perpetuate locating the position of the corner:


"T" Iron (RLS 18659)

- S.W. 42.86 ft. Set PK Nail & County Tag in 10" White Pine
- S.W. 63.1 ft. " " " " in 28" Maple
- S.E. 37.00 ft. " " " " in Util. Pole

N.'ly 38 ft. to centerline of D.E. High Ten. Line Crossing (E.&W).

See attached sheet for additional information.

2159A000 12/29/93RSSU4 9.00
 0001
 2159A000 12/29/93SSRE4 2.00
 0001

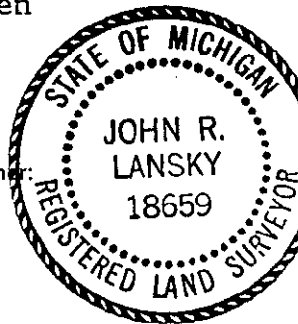

Signed by John R. Lansky
 Surveyor's Michigan License No. 18659

Date Sept 24, 1993

PA 345-1990
 PEER COMMITTEE

APPROVED 11-16-93

APPROVED AS AN OFFICIAL GOVERNMENT CORNER BY ST. CLAIR COUNTY:

Signed By: _____
 St. Clair County Land Surveyor