

**ST. CLAIR COUNTY, MICHIGAN
OFFICIAL GOVERNMENT CORNER**



**LAND CORNER RECORDATION CERTIFICATE
Filing Requirement of Act 74, Mich. P.A. 1970**

Located In: Wales Twp Corner Code ##

- | | | |
|------------------------------------|--------------------------|---------------|
| 1. Public Land Survey | T <u>6N</u> R <u>15E</u> | M-12 |
| | T _____ R _____ | _____ |
| | T _____ R _____ | _____ |
| | T _____ R _____ | _____ |
| 2. Property Controlling in Section | S _____ T _____ R _____ | <u>Sec. 1</u> |
| | S _____ T _____ R _____ | _____ |
| 3. Miscellaneous Property in Sec. | S _____ T _____ R _____ | _____ |
| | S _____ T _____ R _____ | _____ |

RECEIVED
 1993 DEC 29 AM 9:00
 REGISTER OF DEEDS
 ST. CLAIR COUNTY
 Register of Deeds State & File Number

4. Lot No. _____, Recorded Plat _____
 5. Private Claims _____

I, John R. Lansky, in a field survey on Sept. 14-18, 1993
 do hereby certify that under requirements of P.A. 74, Michigan P.A. of 1970, the corner points mentioned in lines 1 and 2 above were in conformance with regulations and rules therefore as required in the current manual of survey instructions of the United States Department of the Interior, Bureau of Land Management or by a decree of a Court of Law and/or that the corner points mentioned in lines 3, 4 and 5 above were in conformance with the rules of the Michigan Board of Land Surveyors or by a Decree of a Court of Law; established, re-established, monumented, re-monumented, recovered, found as expressed below:

	A	B	C	D	E	F	G	H	I	J	K	L	M
2	6	5	4	3	2								
3													
4	7	8	9	10	11	12							
5													
6	16	17	16	15	14	13							
7													
8	19	20	21	22	23	24							
9													
10	30	29	28	27	26	25							
11													
12	31	32	33	34	35	36							
13													

NOTE: Not more than 1 corner, may be recorded on this certificate.

A. Description of original monument and accessories and/or subsequent restoration:

- Post-- Original Gov't Survey.
- Nothing listed on Old Surveyor's Record.
- Found Flat Bar (Leaning) Set "T" Iron
As per Certificate Filed L. 7 P.63

STATE PLAIN COORDINATES

N. _____


E. _____

ELEVATION _____

B. Description of corner evidence found and/or method applied in restoring or reestablishing corner:

Found Iron Bar--Set "T" Iron w/cap RLS 18659.

(Reference also made to additional surveys from this corner although no other certificates were filed)

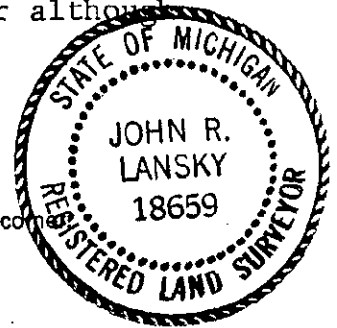

C. Description of monument for corner and accessories established to perpetuate locating the position of the corner:

"T" Iron with Cap RLS 18659

N.W. 84.82 ft. Found Spike & Cap (LLS 31596) in 4" Ash.

West 24.83 ft. Set PK Nail and County Tag in Fence Post (PK Below)

S.E. 27.50 ft. " " " " (PK Below)

Southerly 24.35 ft. to 1/4 Corner for T.6N., R.16E.

(See attached sketch for additional information)

2159A000 12/29/93 MSSU* 9.00
0001

2159A000 12/29/93 SSRE* 2.00
0001

Signed by _____ Date Sept. 20, 1993

John R. Lansky

Surveyor's Michigan License No. 18659

PA 345-1990

PEER COMMITTEE

APPROVED 11-30-93

APPROVED AS AN OFFICIAL GOVERNMENT CORNER BY ST. CLAIR COUNTY:

Signed By: _____

St. Clair County Land Surveyor

Date

Surveyor's Michigan License No. _____