

# ST. CLAIR COUNTY, MICHIGAN OFFICIAL GOVERNMENT CORNER



## LAND CORNER RECORDATION CERTIFICATE Filing Requirement of Act 74, Mich. P.A. 1970

	Located In:	Corner Code #	
1. Public Land Survey	T <u>6N.</u> R <u>15E.</u>	<u>I-1</u>	
	T _____ R _____	_____	
	T _____ R _____	_____	
	T _____ R _____	_____	
2. Property Controlling in Section	S _____ T _____ R _____	<u>Seg 2</u>	
	S _____ T _____ R _____	_____	
3. Miscellaneous Property in Sec.	S _____ T _____ R _____	_____	
	S _____ T _____ R _____	_____	

REGISTERED  
 5/103-41/1110:26  
 REGISTERED  
 117

Register of Deeds Stamp & File Number

4. Lot No. \_\_\_\_\_, Recorded Plat \_\_\_\_\_  
 5. Private Claims \_\_\_\_\_

	A	B	C	D	E	F	G	H	I	J	K	L	M
2	6	5	4	3	2								
3													
4	7	8	9	10	11	12							
5													
6	18	17	16	15	14	13							
7													
8	19	20	21	22	23	24							
9													
10	30	29	28	27	26	25							
11													
12	31	32	33	34	35	36							
13													

**Daniel E. Johnson**                      **April 17,**                      **95**  
 I, \_\_\_\_\_, in a field survey on \_\_\_\_\_, 19\_\_\_\_,  
 do hereby certify that under requirements of P.A. 74, Michigan P.A. of 1970, the corner points mentioned  
 in lines 1 and 2 above were in conformance with regulations and rules therefore as required in the  
 current manual of survey instructions of the United States Department of the Interior, Bureau of Land  
 Management or by a decree of a Court of Law and/or that the corner points mentioned in lines 3, 4 and 5  
 above were in conformance with the rules of the Michigan Board of Land Surveyors or by a Decree of a  
 Court of Law; established, re-established, monumented, re-monumented, recovered, found as  
 expressed below:

**NOTE: Not more than 1 corner, may be recorded on this certificate.**

A. Description of original monument and accessories and/or subsequent restoration:


LIBER 007 PAGE 154

STATE PLAIN COORDINATES

N. \_\_\_\_\_  
 E. \_\_\_\_\_

B. Description of corner evidence found and/or method applied in restoring or reestablishing corner:

LIBER 007 PAGE 154

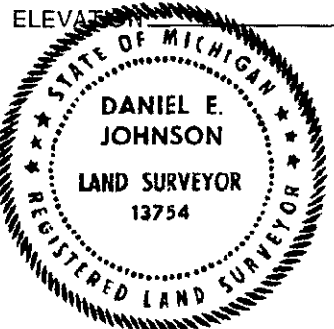

C. Description of monument for corner and accessories established to perpetuate locating the position of the corner:  
 Set 2" dia. aluminum cap inscribed "St Clair County Official Corner"  
 with magnet on top  
Iron with Cap RLS 19835.  
 SW 56.45' to set P.K. and County Tag in NW face of light pole  
 SE 122.17' to set P.K. and County Tag in the N face of D.E.P.  
 NE 109.68' to SW corner of foundation of house #8370  
 N. 59.92' to set P.K. and County Tag in W. face of 8" Pine  
 (corner is on centerline of existing Lapeer Rd. pavement)

Signed by *Daniel E. Johnson*                      Date April 17, 1995  
Daniel E. Johnson  
 13754  
 Surveyor's Michigan License No. \_\_\_\_\_

PA 345-1990  
 PEER COMMITTEE

APPROVED AS AN OFFICIAL GOVERNMENT CORNER BY ST. CLAIR COUNTY:  
 Signed By: *Daniel E. Johnson*                      Date 7-31-95  
 St. Clair County Land Surveyor Daniel E. Johnson  
 13754  
 Surveyor's Michigan License No. \_\_\_\_\_

APPROVED 12-7-93 *Daniel*

Date  
 LIBER 008 PAGE 203