

**ST. CLAIR COUNTY, MICHIGAN
OFFICIAL GOVERNMENT CORNER**



**LAND CORNER RECORDATION CERTIFICATE
Filing Requirement of Act 74, Mich. P.A. 1970**

RECEIVED
ST. CLAIR COUNTY REGISTER OF DEEDS
JUL 13 - 4 11 10: 26

	Located In:	Corner Code #
1. Public Land Survey	T <u>6N.</u> R <u>15E.</u>	<u>G-1</u>
	T _____ R _____	_____
	T _____ R _____	_____
	T _____ R _____	_____
2. Property Controlling in Section	S _____ T _____ R _____	<u>Seg 2</u>
	S _____ T _____ R _____	_____
3. Miscellaneous Property in Sec.	S _____ T _____ R _____	_____
	S _____ T _____ R _____	_____

Register of Deeds Stamp & File Number

4. Lot No. _____, Recorded Plat _____
5. Private Claims _____

Daniel E. Johnson **April 17,** **95**
I, _____, in a field survey on _____, 19_____, do hereby certify that under requirements of P.A. 74, Michigan P.A. of 1970, the corner points mentioned in lines 1 and 2 above were in conformance with regulations and rules therefore as required in the current manual of survey instructions of the United States Department of the Interior, Bureau of Land Management or by a decree of a Court of Law and/or that the corner points mentioned in lines 3, 4 and 5 above were in conformance with the rules of the Michigan Board of Land Surveyors or by a Decree of a Court of Law; established, re-established, monumented, re-monumented, recovered, found as expressed below:

A	B	C	D	E	F	G	H	I	J	K	L	M
2	6	5	4	3	2	1						
3												
4	7	8	9	10	11	12						
5												
6	18	17	16	15	14	13						
7												
8	19	20	21	22	23	24						
9												
10	30	29	28	27	26	25						
11												
12	31	32	33	34	35	36						
13												

NOTE: Not more than 1 corner, may be recorded on this certificate.

A. Description of original monument and accessories and/or subsequent restoration:


LIBER 007 PAGE 163

STATE PLAIN COORDINATES

N. _____
E. _____

B. Description of corner evidence found and/or method applied in restoring or reestablishing corner:

LIBER 007 PAGE 163

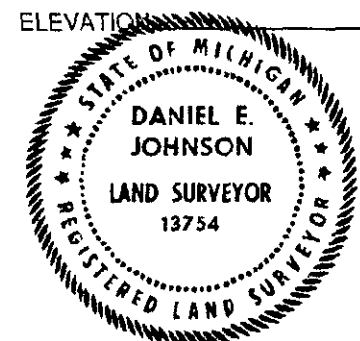

C. Description of monument for corner and accessories established to perpetuate locating the position of the corner:
Set 1/2" x 18" Rerod with 2" dia. aluminum cap inscribed "St Clair County Official Corner" with magnet

**S. 67.30' to set P.K. and County Tag in the NE face of 12" Maple
SW 59.0' to set P.K. and County Tag in the NE face of 8" Maple
SE 72.35' to set P.K. and County Tag in SW face of 12" Poplar.**

Signed by *Daniel E. Johnson* Date April 17, 1995
Daniel E. Johnson
13754
Surveyor's Michigan License No. _____

PA 345-1990
PEER COMMITTEE
APPROVED 12-14-93 *Daniel*

APPROVED AS AN OFFICIAL GOVERNMENT CORNER BY ST. CLAIR COUNTY:
Signed By: *Daniel E. Johnson* Date 7-31-95
St. Clair County Land Surveyor **Daniel e. Johnson**
13754
Surveyor's Michigan License No. _____