ST. CLAIR COUNTY, MICHIGAN
OFFICIAL GOVERNMENT CORNER

LAND CORNER RECORDATION CERTIFICATE
Filing Requirement of Act 74, Mich. P.A. 1970

		Located In: Wales Twp.	Corner Code #
1. Public Land Survey		T 6N R 15E	B-1
		T ____ R ____	
		T ____ R ____	
		T ____ R ____	
2. Property Controlling	S ____	T ____ R ____	
in Section	S ____	T ____ R ____	Seg 2
3. Miscellaneous	S ____	T ____ R ____	
Property in Sec.	S ____	T ____ R ____	

Register of Deeds Stamp & File Number

4. Lot No. _____ , Recorded Plat _____
5. Private Claims _____

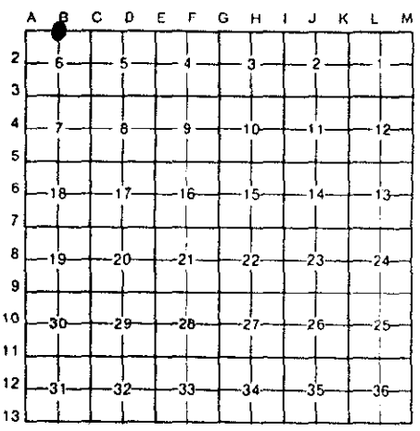

I, Daniel E. Johnson, in a field survey on May 11, 95, 19 ____ do hereby certify that under requirements of P.A. 74, Michigan P.A. of 1970, the corner points mentioned in lines 1 and 2 above were in conformance with regulations and rules therefore as required in the current manual of survey instructions of the United States Department of the Interior, Bureau of Land Management or by a decree of a Court of Law and/or that the corner points mentioned in lines 3, 4 and 5 above were in conformance with the rules of the Michigan Board of Land Surveyors or by a Decree of a Court of Law; established, re-established, monumented, re-monumented, recovered, found as expressed below:

NOTE: Not more than 1 corner, may be recorded on this certificate.

A. Description of original monument and accessories and/or subsequent restoration:

SEE LIBER 007 PAGE 183
This corner not set on Government Survey
Nothing listed on Old Surveyor's Record. St. Clair County.
Nothing recorded for this corner.

STATE PLAIN COORDINATES

N. _____

E. _____

ELEVATION _____

B. Description of corner evidence found and/or method applied in restoring or reestablishing corner:

SEE LIBER 007 PAGE 183
Set "T" Iron stamped LLS 31596
Set "T" Iron on line with the NW Corner Section 6, T6N, R15E and the NE Corner section 6, T6N, R15E, and also in line with the Old fence line running south.
Corner is 5.0' North of fence running east for about 60' only.
Corner is in agreement with fence going south.

C. Description of monument for corner and accessories established to perpetuate locating the position of the corner:

Set 2" dia aluminum cap inscribed "St. Clair County Offical Corner" with magnet on a "T" Iron stamped LLS 31596.
S.E. 21.0' to set P.K. & County Tag in W face of 24" Beech.
E. 58.60' to set P.K. and County Tag in N face of 60" Maple.
N. 28.17' to set P.K. and County Tag in E face of 15" Beech.
WNW 27.30' to set P.K. and County Tag in N face of 18" Maple.

STATE OF MICHIGAN
DANIEL E. JOHNSON
LAND SURVEYOR
13754
REGISTERED LAND SURVEYOR

Signed by Daniel E. Johnson Date May 11, 1995

Surveyor's Michigan License No. 13754

PA 345-1990
PEER COMMITTEE
APPROVED 12-14-93

APPROVED AS AN OFFICIAL GOVERNMENT CORNER BY ST. CLAIR COUNTY:

Signed By: Daniel E. Johnson 7-31-95
St. Clair County Land Surveyor Date

Surveyor's Michigan License No. 13754

LIBER 008 PAGE 210