

# ST. CLAIR COUNTY, MICHIGAN OFFICIAL GOVERNMENT CORNER



## LAND CORNER RECORDATION CERTIFICATE Filing Requirement of Act 74, Mich. P.A. 1970

Located In: \_\_\_\_\_ Corner Code # \_\_\_\_\_

		<b>Wales Twp.</b>		
1. Public Land Survey	T	<u>6N</u>	R	<u>15E</u>
	T	_____	R	_____
	T	_____	R	_____
	T	_____	R	_____
2. Property Controlling in Section	S	_____	T	_____
	S	_____	T	_____
3. Miscellaneous Property in Sec.	S	_____	T	_____
	S	_____	T	_____

Seg. 2

RECEIVED  
 1995 JUN -4 AM 10:25  
 REGISTER OF DEEDS  
 ST. CLAIR COUNTY, MICHIGAN  
 Register of Deeds Stamp & File Number

4. Lot No. \_\_\_\_\_, Recorded Plat \_\_\_\_\_  
 5. Private Claims \_\_\_\_\_

	A	B	C	D	E	F	G	H	I	J	K	L	M
2	6	5	4	3	2	1							
3													
4	7	8	9	10	11	12							
5													
6	18	17	16	15	14	13							
7													
8	19	20	21	22	23	24							
9													
10	30	29	28	27	26	25							
11													
12	31	32	33	34	35	36							
13													

**Daniel E. Johnson** Jan. 31 1995  
 I, \_\_\_\_\_ in a field survey on \_\_\_\_\_, 19\_\_\_\_  
 do hereby certify that under requirements of P.A. 74, Michigan P.A. of 1970, the corner points mentioned in lines 1 and 2 above were in conformance with regulations and rules therefore as required in the current manual of survey instructions of the United States Department of the Interior, Bureau of Land Management or by a decree of a Court of Law and/or that the corner points mentioned in lines 3, 4 and 5 above were in conformance with the rules of the Michigan Board of Land Surveyors or by a Decree of a Court of Law; established, re-established, monumented, re-monumented, recovered, found as expressed below:

**NOTE: Not more than 1 corner, may be recorded on this certificate.**

A. Description of original monument and accessories and/or subsequent restoration:


**LIBER 007 PAGE 92**

STATE PLAIN COORDINATES

N. \_\_\_\_\_  
 E. \_\_\_\_\_

B. Description of corner evidence found and/or method applied in restoring or reestablishing corner:

**LIBER 007 PAGE 92**

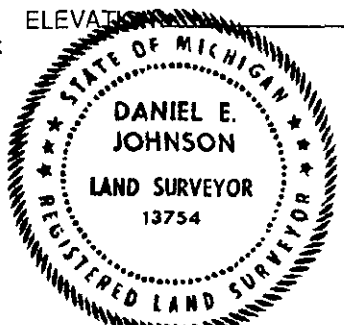

ELEVATION \_\_\_\_\_

C. Description of monument for corner and accessories established to perpetuate locating the position of the corner:

Set 2" dia. aluminum cap inscribed "St. Clair County Official Corner" with magnet (in Monument Box) on a Concrete Monument (With Iron Rod Inserted)  
 N.W. 43.57 Set PK Nail with County Tag in D.E. Pole  
 N.E. 67.8 to center of Sun Pipe line marker  
 S.E. 77.4 to N.W. Corner of N/S. Conc. Headwall  
 S.W. 77.7 to N.E. Corner of N/S. Conc. Headwall

Note: Found Iron Rod 4.27 ft. SE'ly (Road P.I) ref. AD Plans No. 53 and 106

Signed by Daniel E. Johnson Date January 31, 1995  
 Daniel E. Johnson  
 13754  
 Surveyor's Michigan License No. \_\_\_\_\_

PA 345-1990  
 PEER COMMITTEE

APPROVED AS AN OFFICIAL GOVERNMENT CORNER BY ST. CLAIR COUNTY:

Signed By: Daniel E. Johnson : 7-31-95  
 St. Clair County Land Surveyor Daniel E. Johnson Date  
 13754  
 Surveyor's Michigan License No. \_\_\_\_\_

APPROVED 11-30-93  
 Date  
 LIBER **008** PAGE **186**