ST. CLAIR COUNTY, MICHIGAN
OFFICIAL GOVERNMENT CORNER

LAND CORNER RECORDATION CERTIFICATE
Filing Requirement of Act 74, Mich. P.A. 1970

		Located In:	Corner Code #
1. Public Land Survey		T ~~6N.~~ R ~~15E.~~ Wales Twp.	~~M-12~~
		T ____ R ____	
		T ____ R ____	
		T ____ R ____	
2. Property Controlling	S ____	T ____ R ____	
in Section	S ____	T ____ R ____	Seg. 2
3. Miscellaneous	S ____	T ____ R ____	
Property in Sec.	S ____	T ____ R ____	

RECEIVED 1995 JUN -4 AM 10:2

Register of Deeds Stamp & File Number

4. Lot No. _____ , Recorded Plat _____
5. Private Claims _____

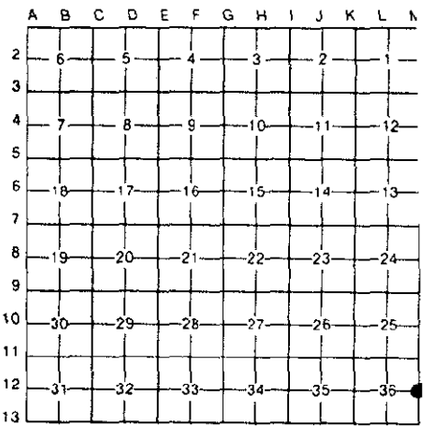

I, Daniel E. Johnson, in a field survey on January 31, 19 95, do hereby certify that under requirements of P.A. 74, Michigan P.A. of 1970, the corner points mentioned in lines 1 and 2 above were in conformance with regulations and rules therefore as required in the current manual of survey instructions of the United States Department of the Interior, Bureau of Land Management or by a decree of a Court of Law and/or that the corner points mentioned in lines 3, 4 and 5 above were in conformance with the rules of the Michigan Board of Land Surveyors or by a Decree of a Court of Law; established, re-established, monumented, re-monumented, recovered, found as expressed below:

NOTE: Not more than 1 corner, may be recorded on this certificate.

A. Description of original monument and accessories and/or subsequent restoration:

LIBER 007 PAGE 96

STATE PLAIN COORDINATES

N. _____

E. _____

ELEVATION _____

B. Description of corner evidence found and/or method applied in restoring or reestablishing corner:

LIBER 007 PAGE 96

STATE OF MICHIGAN
DANIEL E. JOHNSON
LAND SURVEYOR
13754
REGISTERED LAND SURVEYOR

C. Description of monument for corner and accessories established to perpetuate locating the position of the corner:

Set 2" dia. aluminum cap inscribed "St Clair County Official Corner" with magnet on a "T" Iron with Cap RLS 18659.
N.W. 84.82 ft. Found Spike & Cap (LLS 31596) IN 4" Ash
West 24.83 ft. Set PK Nail and County Tag in Fence Post (PK Below)
S.E. 27.50 ft. " " " " " " "
Southerly 24.35 ft. to 1/4 Corner for T.6N., R.16E.

Signed by Daniel E. Johnson ~~Daniel E. Johnson~~ Date June 23, 1995

Surveyor's Michigan License No. 13754

PA 345-1990
PEER COMMITTEE
APPROVED 11-30-93

APPROVED AS AN OFFICIAL GOVERNMENT CORNER BY ST. CLAIR COUNTY:

Signed By: Daniel E. Johnson : 7-31-96

St. Clair County Land Surveyor Daniel E. Johnson Date

Surveyor's Michigan License No. 13754

LIBER 008 PAGE 187