ST. CLAIR COUNTY, MICHIGAN
OFFICIAL GOVERNMENT CORNER

LAND CORNER RECORDATION CERTIFICATE
Filing Requirement of Act 74, Mich. P.A. 1970

	Located In:	Corner Code #
1. Public Land Survey	T6N. R15E.	J-1
	T ___ R ___	
	T ___ R ___	
	T ___ R ___	
2. Property Controlling	S ___ T ___ R ___	
in Section	S ___ T ___ R ___	Sec. 2
3. Miscellaneous	S ___ T ___ R ___	
Property in Sec.	S ___ T ___ R ___	

RECEIVED 1995 APR -4 AM 10:16

Register of Deeds Stamp & File Number

4. Lot No. _____ , Recorded Plat _____
5. Private Claims _____

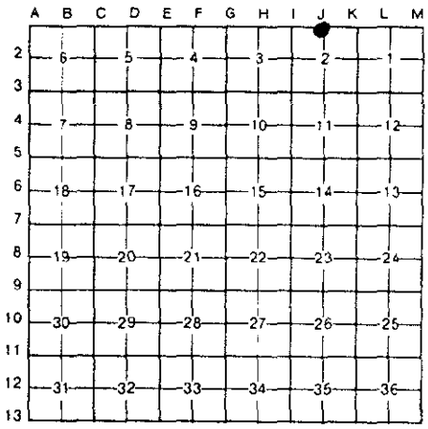

Daniel E. Johnson April 17, 95

I, _____ , in a field survey on _____ , 19 _____ , do hereby certify that under requirements of P.A. 74, Michigan P.A. of 1970, the corner points mentioned in lines 1 and 2 above were in conformance with regulations and rules therefore as required in the current manual of survey instructions of the United States Department of the Interior, Bureau of Land Management or by a decree of a Court of Law and/or that the corner points mentioned in lines 3, 4 and 5 above were in conformance with the rules of the Michigan Board of Land Surveyors or by a Decree of a Court of Law; established, re-established, monumented, re-monumented, recovered, found as expressed below:

NOTE: Not more than 1 corner, may be recorded on this certificate.

A. Description of original monument and accessories and/or subsequent restoration:

LIBER 007 PAGE 150

STATE PLAIN COORDINATES

N. _____

E. _____

ELEVATION _____

B. Description of corner evidence found and/or method applied in restoring or reestablishing corner:

LIBER 007 PAGE 150

STATE OF MICHIGAN
DANIEL E. JOHNSON
LAND SURVEYOR
13754
REGISTERED LAND SURVEYOR

C. Description of monument for corner and accessories established to perpetuate locating the position of the corner:

Set 2" dia. aluminum cap inscribed "St Clair County Official Corner" with magnet (in Monument Box) on a Iron in Monument Box.
N. 50.73' to set P.K. and County Tag in E. face of utility pole
SE 94.70' to set P.K. and County Tag in NW face of D.E.P.
NE 186.57' to set P.K. and County Tag in SE face of utility pole
(corner is on centerline of existing Lapeer Road pavement)
(corner is on centerline of existing Lapeer Rd. pavement)

Signed by Daniel E. Johnson ~~Daniel E. Johnson~~ Date April 17, 1995

Surveyor's Michigan License No. 13754

PA 345-1990
~~PEER COMMITTEE~~
APPROVED 12-7-93

APPROVED AS AN OFFICIAL GOVERNMENT CORNER BY ST. CLAIR COUNTY:

Signed By: Daniel E. Johnson ~~Daniel E. Johnson~~ : 7-31-95
St. Clair County Land Surveyor Date

Surveyor's Michigan License No. 13754

LIBER 008 PAGE 202