

ST. CLAIR COUNTY, MICHIGAN OFFICIAL GOVERNMENT CORNER



LAND CORNER RECORDATION CERTIFICATE Filing Requirement of Act 74, Mich. P.A. 1970

Located In: Corner Code #

- | | | |
|------------------------------------|----------------------------|----------------|
| 1. Public Land Survey | T <u>6N.</u> R <u>15E.</u> | - <u>K-1</u> - |
| | T _____ R _____ | _____ |
| | T _____ R _____ | _____ |
| | T _____ R _____ | _____ |
| 2. Property Controlling in Section | S _____ T _____ R _____ | <u>Sec. 2</u> |
| | S _____ T _____ R _____ | _____ |
| 3. Miscellaneous Property in Sec. | S _____ T _____ R _____ | _____ |
| | S _____ T _____ R _____ | _____ |

RECEIVED
 REGISTER OF DEEDS
 ST. CLAIR COUNTY, MICHIGAN
 APR 17 1995 AM 10:26
 REGISTER OF DEEDS STAMP & FILE NUMBER

4. Lot No. _____, Recorded Plat _____
5. Private Claims _____

	A	B	C	D	E	F	G	H	I	J	K	L	M
2	6	5	4	3	2	1							
3													
4	7	8	9	10	11	12							
5													
6	18	17	16	15	14	13							
7													
8	19	20	21	22	23	24							
9													
10	30	29	28	27	26	25							
11													
12	31	32	33	34	35	36							
13													

Daniel E. Johnson April 17, 1995

I, _____, in a field survey on _____, 19____, do hereby certify that under requirements of P.A. 74, Michigan P.A. of 1970, the corner points mentioned in lines 1 and 2 above were in conformance with regulations and rules therefore as required in the current manual of survey instructions of the United States Department of the Interior, Bureau of Land Management or by a decree of a Court of Law and/or that the corner points mentioned in lines 3, 4 and 5 above were in conformance with the rules of the Michigan Board of Land Surveyors or by a Decree of a Court of Law; established, re-established, monumented, re-monumented, recovered, found as expressed below:

NOTE: Not more than 1 corner, may be recorded on this certificate.

A. Description of original monument and accessories and/or subsequent restoration:


LIBER 007 PAGE 147

STATE PLAIN COORDINATES

N. _____
E. _____

E. Description of corner evidence found and/or method applied in restoring or reestablishing corner:

LIBER 007 PAGE 147

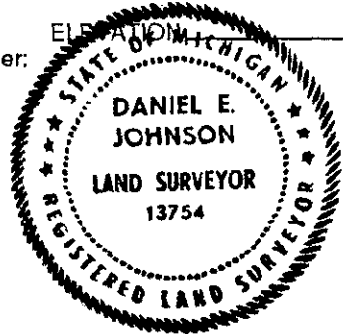

C. Description of monument for corner and accessories established to perpetuate locating the position of the corner:

Set 2" dia. aluminum cap inscribed "St Clair County Official Corner" with magnet (in Monument Box)
Witnesses are to Corner which is 0.13 South of 1" Iron in Monument Box
 SW 116.07' to set P.K. and County Tag in E. face of 12" Ash
 SSE 126.73' to set P.K. and County Tag in W. face of D.E.P.
 SE 58.48' to set P.K. and County Tag in W. face of D.E.P.
 NE 71.40' to set P.K. and County Tag in SE face of telephone pole (corner is on centerline of existing Lapeer Rd. pavement)

Signed by Daniel E. Johnson
 Daniel E. Johnson
 13754
 Surveyor's Michigan License No. _____

Date April 17, 1995

PA 345-1990
PEER COMMITTEE

APPROVED 12-7-93 *[Signature]*

APPROVED AS AN OFFICIAL GOVERNMENT CORNER BY ST. CLAIR COUNTY:

Signed By: Daniel E. Johnson
 St. Clair County Land Surveyor **Daniel E. Johnson**
 13754
 Surveyor's Michigan License No. _____

Date 7-31-95

LIBER **008** PAGE **201**