

ST. CLAIR COUNTY, MICHIGAN OFFICIAL GOVERNMENT CORNER



LAND CORNER RECORDATION CERTIFICATE Filing Requirement of Act 74, Mich. P.A. 1970

RECEIVED
 REGISTER OF DEEDS
 ST. CLAIR COUNTY
 APR - 4 AM 10:26

	Located In:	Corner Code #
	Wales Twp.	
1. Public Land Survey	T <u>6N.</u> R <u>15E.</u>	<u>M-1</u>
	T _____ R _____	_____
	T _____ R _____	_____
	T _____ R _____	_____
2. Property Controlling in Section	S _____ T _____ R _____	<u>Seg. #3</u>
	S _____ T _____ R _____	_____
3. Miscellaneous Property in Sec.	S _____ T _____ R _____	_____
	S _____ T _____ R _____	_____

Register of Deeds Stamp & File Number

4. Lot No. _____, Recorded Plat _____
 5. Private Claims _____

I, **Daniel E. Johnson**, on **April 17, 1995**, in a field survey on _____, do hereby certify that under requirements of P.A. 74, Michigan P.A. of 1970, the corner points mentioned in lines 1 and 2 above were in conformance with regulations and rules therefore as required in the current manual of survey instructions of the United States Department of the Interior, Bureau of Land Management or by a decree of a Court of Law and/or that the corner points mentioned in lines 3, 4 and 5 above were in conformance with the rules of the Michigan Board of Land Surveyors or by a Decree of a Court of Law, established, re-established, monumented, re-monumented, recovered, found as expressed below:

	A	B	C	D	E	F	G	H	I	J	K	L	M
2	6	5	4	3	2	1							
3													
4	7	8	9	10	11	12							
5													
6	18	17	16	15	14	13							
7													
8	19	20	21	22	23	24							
9													
10	30	29	28	27	26	25							
11													
12	31	32	33	34	35	36							
13													

NOTE: Not more than 1 corner, may be recorded on this certificate.

A. Description of original monument and accessories and/or subsequent restoration:

LIBER 007 PAGE 138


STATE PLAIN COORDINATES

N. _____

E. _____

B. Description of corner evidence found and/or method applied in restoring or reestablishing corner:

LIBER 007 PAGE 138

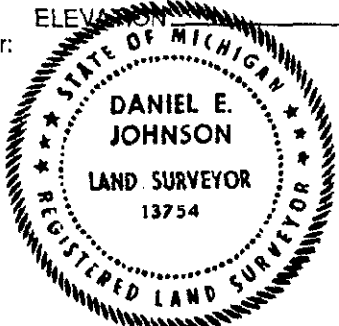

C. Description of monument for corner and accessories established to perpetuate locating the position of the corner:
Set 2" dia. aluminum cap inscribed "St Clair County Official Corner" with magnet (in Monument Box) on an Axle in Monument Box.
 S. 49.97' to P.K. and County Tag in W. face of D.E.P.
 NNE 54.72' to P.K. and County Tag in SW face of D.E.P.
 NW 92.80' to P.K. and County Tag in SW face of Telephone Pole
 W. 1843.60' to SW Corner Section 31 T7N, R16E.
 (Corner is on centerline of existing Lapeer Road pavement)
This corner common to NW corner Sectin 6 T6N, R16E (A-1)

Signed by *Daniel E. Johnson* Date April 17, 1995
Daniel E. Johnson
 13754
 Surveyor's Michigan License No. _____

PA 345-1990
 PEER COMMITTEE
 APPROVED 12-7-93 *Dennis*

APPROVED AS AN OFFICIAL GOVERNMENT CORNER BY ST. CLAIR COUNTY:
 Signed By: *Daniel E. Johnson* Date 7-31-95
 St. Clair County Land Surveyor Daniel E. Johnson
 13754
 Surveyor's Michigan License No. _____

Date
 LIBER **008** PAGE **199**