

ST. CLAIR COUNTY, MICHIGAN OFFICIAL GOVERNMENT CORNER



LAND CORNER RECORDATION CERTIFICATE Filing Requirement of Act 74, Mich. P.A. 1970

	Located In:	Corner Code #	
1. Public Land Survey	Kimball Twp. 6N. R. 16E.	A-1	
	T _____ R _____	_____	_____
	T _____ R _____	_____	_____
	T _____ R _____	_____	_____
2. Property Controlling in Section	S _____ T _____ R _____	_____	_____
	S _____ T _____ R _____	_____	_____
3. Miscellaneous Property in Sec.	S _____ T _____ R _____	_____	_____
	S _____ T _____ R _____	_____	_____

RECEIVED
 1993 FEB 29 AM 9:03
 REGISTER OF DEEDS
 ST. CLAIR COUNTY
 Register of Deeds Stamp & File Number

4. Lot No. _____, Recorded Plat _____
 5. Private Claims _____

I, John R. Lansky in a field survey on Oct. 4-12, 1993 do hereby certify that under requirements of P.A. 74, Michigan P.A. of 1970, the corner points mentioned in lines 1 and 2 above were in conformance with regulations and rules therefore as required in the current manual of survey instructions of the United States Department of the Interior, Bureau of Land Management or by a decree of a Court of Law and/or that the corner points mentioned in lines 3, 4 and 5 above were in conformance with the rules of the Michigan Board of Land Surveyors or by a Decree of a Court of Law; established, re-established, monumented, re-monumented, recovered, found as expressed below:

	A	B	C	D	E	F	G	H	I	J	K	L	M
2	6	5	4	3	2								
3													
4	7	8	9	10	11	12							
5													
6	18	17	16	15	14	13							
7													
8	19	20	21	22	23	24							
9													
10	30	29	28	27	26	25							
11													
12	31	32	33	34	35	36							
13													

NOTE: Not more than 1 corner, may be recorded on this certificate.

- A. Description of original monument and accessories and/or subsequent restoration:
1. Post-- Original Gov't Survey.
 2. Nothing listed on Old Surveyor's Record St. Clair County, although witnesses shown.
 3. Iron in Mon Box. per Certificate L.2 P.247

STATE PLAIN COORDINATES

N. _____

E. _____

ELEVATION _____


- B. Description of corner evidence found and/or method applied in restoring or reestablishing corner:
 Found Axle in Monument Box

2159A000 12/29/93MSSU4 9.00
 0001
 2159A000 12/29/93SSRE4 2.00
 0003

- C. Description of monument for corner and accessories established to perpetuate locating the position of the corner:

Axle in Monument Box

S'yly 49.96 ft. set PK nail & tag in D.E. Pole
 N.E. 54.70 ft. " " " " "
 N.W. 92.30 ft. " " " in MBT Pole
 (Corner is on centedline of existing Lapeer Rd. Pav't).

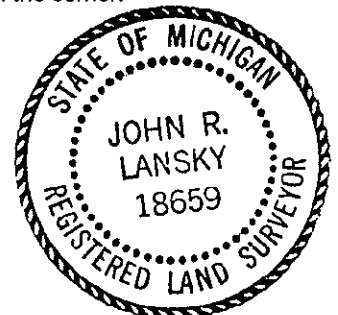

See attached sketch for additional information.

Signed by John R. Lansky
 Surveyor's Michigan License No. 18659

Date Oct. 13, 1993

PA 345-1990
 PEER COMMITTEE

APPROVED 11-23-93.

APPROVED AS AN OFFICIAL GOVERNMENT CORNER BY ST. CLAIR COUNTY:

Signed By: _____ Date _____
 St. Clair County Land Surveyor

Surveyor's Michigan License No. _____