

# ST. CLAIR COUNTY, MICHIGAN OFFICIAL GOVERNMENT CORNER



## LAND CORNER RECORDATION CERTIFICATE Filing Requirement of Act 74, Mich. P.A. 1970

Located In: \_\_\_\_\_ Corner Code # \_\_\_\_\_

	<b>Kimball Twp.</b>		
1. Public Land Survey	T <u>6N.</u> R <u>16E.</u>	<u>A-3</u>	
	T _____ R _____		
	T _____ R _____		
	T _____ R _____		
2. Property Controlling in Section	S _____ T _____ R _____	<u>Sec 2</u>	
	S _____ T _____ R _____		
3. Miscellaneous Property in Sec.	S _____ T _____ R _____		
	S _____ T _____ R _____		

RECEIVED  
REGISTER OF DEEDS  
ST. CLAIR COUNTY  
1995 AUG -4 AM 10:11  
Register of Deeds Stamp & File Number

4. Lot No. \_\_\_\_\_, Recorded Plat \_\_\_\_\_  
5. Private Claims \_\_\_\_\_

**Daniel E. Johnson**                      **JUNE 23**                      **95**  
I, \_\_\_\_\_, in a field survey on \_\_\_\_\_, 19\_\_\_\_,  
do hereby certify that under requirements of P.A. 74, Michigan P.A. of 1970, the corner points mentioned in lines 1 and 2 above were in conformance with regulations and rules therefore as required in the current manual of survey instructions of the United States Department of the Interior, Bureau of Land Management or by a decree of a Court of Law and/or that the corner points mentioned in lines 3, 4 and 5 above were in conformance with the rules of the Michigan Board of Land Surveyors or by a Decree of a Court of Law; established, re-established, monumented, re-monumented, recovered, found as expressed below:

	A	B	C	D	E	F	G	H	I	J	K	L	M
2	6	5	4	3	2	1							
3	7	8	9	10	11	12							
4	18	17	16	15	14	13							
5	19	20	21	22	23	24							
6	30	29	28	27	26	25							
7	31	32	33	34	35	36							
8													
9													
10													
11													
12													

**NOTE: Not more than 1 corner, may be recorded on this certificate.**

A. Description of original monument and accessories and/or subsequent restoration:

**LIBER 007 PAGE 128**


**STATE PLAIN COORDINATES**

N. \_\_\_\_\_  
E. \_\_\_\_\_

B. Description of corner evidence found and/or method applied in restoring or reestablishing corner:

**LIBER 007 PAGE 128**

ELEVATION \_\_\_\_\_

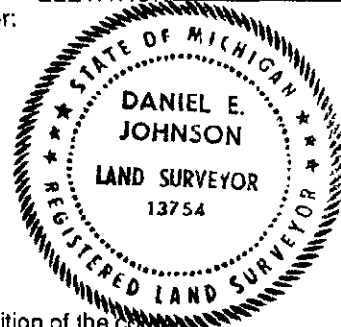

C. Description of monument for corner and accessories established to perpetuate locating the position of the corner:  
**"Accepted Michigan Department of Transportation Brass Disc"**  
**Rod with Disc. (at Fence line intersection Fence N,S,E)**  
 N'ly 7.30 ft. Set PK Nail & Tag in 18" Black Cherry  
 E'ly 24.30 ft. Set PK Nail & Tag in 12" Ash  
 S'ly 17.55 ft Set PK Nail & Tag in 15" Oak

Signed by Daniel E. Johnson                      Date June 23, 1995  
 Daniel E. Johnson                      13754

Surveyor's Michigan License No. \_\_\_\_\_                      PA 345-1990  
 \_\_\_\_\_                      PEER COMMITTEE

APPROVED AS AN OFFICIAL GOVERNMENT CORNER BY ST. CLAIR COUNTY:  
 Signed By: Daniel E. Johnson                      Date 7-31-95  
 St. Clair County Land Surveyor **Daniel E. Johnson**                      13754  
 Surveyor's Michigan License No. \_\_\_\_\_                      LIBER 008 PAGE 143