

ST. CLAIR COUNTY, MICHIGAN OFFICIAL GOVERNMENT CORNER



LAND CORNER RECORDATION CERTIFICATE Filing Requirement of Act 74, Mich. P.A. 1970

Located In: Kimball Twp. Corner Code # A-4

- | | | | |
|------------------------------------|----------------------------|--|---------------|
| 1. Public Land Survey | T <u>6N.</u> R <u>16E.</u> | | |
| | T _____ R _____ | | _____ |
| | T _____ R _____ | | _____ |
| | T _____ R _____ | | _____ |
| 2. Property Controlling in Section | S _____ T _____ R _____ | | <u>Sec. 2</u> |
| | S _____ T _____ R _____ | | _____ |
| 3. Miscellaneous Property in Sec. | S _____ T _____ R _____ | | _____ |
| | S _____ T _____ R _____ | | _____ |

RECEIVED
1995 AUG - 4 AM 10:19
REGISTER OF DEEDS
ST. CLAIR COUNTY
Register of Deeds Stamp & File Number

4. Lot No. _____, Recorded Plat _____
5. Private Claims _____

I, Daniel E. Johnson January 30 95
in a field survey on _____, 19____,
do hereby certify that under requirements of P.A. 74, Michigan P.A. of 1970, the corner points mentioned in lines 1 and 2 above were in conformance with regulations and rules theretofore as required in the current manual of survey instructions of the United States Department of the Interior, Bureau of Land Management or by a decree of a Court of Law and/or that the corner points mentioned in lines 3, 4 and 5 above were in conformance with the rules of the Michigan Board of Land Surveyors or by a Decree of a Court of Law; established, re-established, monumented, re-monumented, recovered, found as expressed below:

A	B	C	D	E	F	G	H	I	J	K	L	M
2	6	5	4	3	2	1						
3												
4	7	8	9	10	11	12						
5												
6	18	17	16	15	14	13						
7												
8	19	20	21	22	23	24						
9												
10	30	29	28	27	26	25						
11												
12	31	32	33	34	35	36						
13												

NOTE: Not more than 1 corner, may be recorded on this certificate.

- A. Description of original monument and accessories and/or subsequent restoration:

LIBER 007 PAGE 124

STATE PLAIN COORDINATES


N. _____

E. _____

ELEVATION _____

- B. Description of corner evidence found and/or method applied in restoring or reestablishing corner:

LIBER 007 PAGE 124

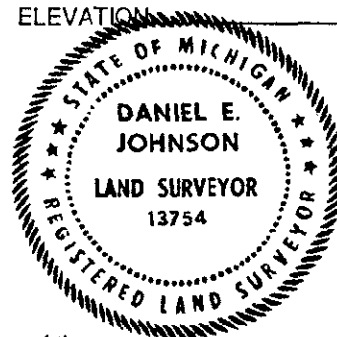

- C. Description of monument for corner and accessories established to perpetuate locating the position of the corner:
Set 2" dia. aluminum cap inscribed "St. Clair County Official Corner" with magnet on a T IRON
E.S.E. 44.78 Found Spike & Cap RLS 18659 in Twin Maple
S.W. 50.20 ft. Found Spike & Cap RLS 18659 in D.E. Pole
North 42 ft. to centerline of Sparling Rd. Pavement (in transition)

Signed by Daniel E. Johnson Date January 30, 1995
Daniel E. Johnson
 13754
 Surveyor's Michigan License No. _____

PA 345-1990
PEER COMMITTEE

APPROVED AS AN OFFICIAL GOVERNMENT CORNER BY ST. CLAIR COUNTY:
 Signed By: Daniel E. Johnson : 7-31-95 Date
 St. Clair County Land Surveyor Daniel E. Johnson
 13754
 Surveyor's Michigan License No. _____

APPROVED 11-23-93
Deno