

ST. CLAIR COUNTY, MICHIGAN OFFICIAL GOVERNMENT CORNER



LAND CORNER RECORDATION CERTIFICATE Filing Requirement of Act 74, Mich. P.A. 1970

Located In: _____ Corner Code # _____

Kimball Twp.

1. Public Land Survey	T	6N.	R	16E.	A-5	
	T		R			
	T		R			
	T		R			
	T		R			
2. Property Controlling in Section	S		T		R	
	S		T		R	<i>Sec 2</i>
3. Miscellaneous Property in Sec.	S		T		R	
	S		T		R	

RECEIVED
REGISTERED LAND SURVEYOR
ST. CLAIR COUNTY

1995 AUG -4 AM 10:15

Register of Deeds Stamp & File Number

4. Lot No. _____, Recorded Plat _____
5. Private Claims _____

Daniel E. Johnson **January 30** **95**
I, _____, in a field survey on _____, 19____
do hereby certify that under requirements of P.A. 74, Michigan P.A. of 1970, the corner points mentioned in lines 1 and 2 above were in conformance with regulations and rules therefore as required in the current manual of survey instructions of the United States Department of the Interior, Bureau of Land Management or by a decree of a Court of Law and/or that the corner points mentioned in lines 3, 4 and 5 above were in conformance with the rules of the Michigan Board of Land Surveyors or by a Decree of a Court of Law; established, re-established, monumented, re-monumented, recovered, found as expressed below:

	A	B	C	D	E	F	G	H	I	J	K	L	M
2	6	5	4	3	2	1							
3													
4	7	8	9	10	11	12							
5													
6	18	17	16	15	14	13							
7													
8	19	20	21	22	23	24							
9													
10	30	29	28	27	26	25							
11													
12	31	32	33	34	35	36							
13													

NOTE: Not more than 1 corner, may be recorded on this certificate.

A. Description of original monument and accessories and/or subsequent restoration:

LIBER 007 PAGE 120


STATE PLAIN COORDINATES

N. _____
E. _____

B. Description of corner evidence found and/or method applied in restoring or reestablishing corner:

LIBER 007 PAGE 120

ELEVATION _____

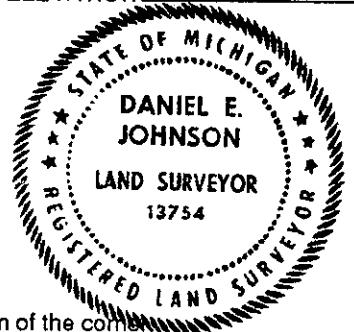

C. Description of monument for corner and accessories established to perpetuate locating the position of the corner:
Set 2" dia. aluminum cap inscribed "St. Clair County Official Corner"
with magnet on a
T IRON
E.N.E. 38.53 ft. Set PK Nail & Tag in 12" Elm
N.E. 90.52 ft. Set PK Nail & Tag in 8" Elm
S.W. 81.7 ft. Found Spike & Cap (RLS 18659) in D.E. Pole
Northerly 57.94 ft. to N.E. cor. Sec. 13, T.6N., R.15E

Signed by *Daniel E. Johnson*
Daniel E. Johnson
13754
Surveyor's Michigan License No. _____

Date **January 30, 1995**

**PA 345-1990
PEER COMMITTEE**

APPROVED AS AN OFFICIAL GOVERNMENT CORNER BY ST. CLAIR COUNTY:

APPROVED 11-23-93
Daniel E. Johnson

Signed By: *Daniel E. Johnson*
St. Clair County Land Surveyor **Daniel E. Johnson**
13754
Surveyor's Michigan License No. _____

Date **7-31-95**