

ST. CLAIR COUNTY, MICHIGAN OFFICIAL GOVERNMENT CORNER



LAND CORNER RECORDATION CERTIFICATE Filing Requirement of Act 74, Mich. P.A. 1970

RECEIVED
 REGISTER OF DEEDS
 ST. CLAIR COUNTY
 JAN 31 1995

Located In: _____ Corner Code # _____

Kimball Twp.

- | | | | |
|------------------------------------|----------------------------|-----|---------------|
| 1. Public Land Survey | T <u>6N.</u> R <u>16E.</u> | A-6 | |
| | T _____ R _____ | | |
| | T _____ R _____ | | |
| | T _____ R _____ | | |
| | T _____ R _____ | | |
| 2. Property Controlling in Section | S _____ T _____ R _____ | | |
| | S _____ T _____ R _____ | | <i>Sec. 2</i> |
| 3. Miscellaneous Property in Sec. | S _____ T _____ R _____ | | |
| | S _____ T _____ R _____ | | |

Register of Deeds Stamp & File Number

4. Lot No. _____, Recorded Plat _____
5. Private Claims _____

Daniel E. Johnson **January 30** **95**

I, _____, in a field survey on _____, 19_____, do hereby certify that under requirements of P.A. 74, Michigan P.A. of 1970, the corner points mentioned in lines 1 and 2 above were in conformance with regulations and rules therefore as required in the current manual of survey instructions of the United States Department of the Interior, Bureau of Land Management or by a decree of a Court of Law and/or that the corner points mentioned in lines 3, 4 and 5 above were in conformance with the rules of the Michigan Board of Land Surveyors or by a Decree of a Court of Law; established, re-established, monumented, re-monumented, recovered, found as expressed below:

NOTE: Not more than 1 corner, may be recorded on this certificate.

A. Description of original monument and accessories and/or subsequent restoration:


LIBER 007 PAGE 118

STATE PLAIN COORDINATES

N. _____
E. _____

B. Description of corner evidence found and/or method applied in restoring or reestablishing corner:

LIBER 007 PAGE 118

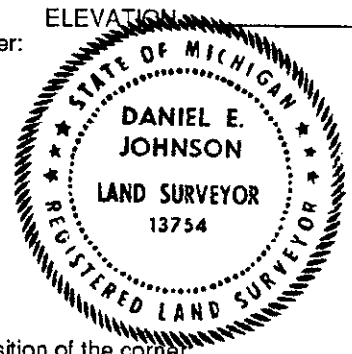

C. Description of monument for corner and accessories established to perpetuate locating the position of the corner.

Set 1/2" Rebar with 2" dia. aluminum cap inscribed "St. Clair County Official Corner" with magnet on an OLD IRON PIPE.

E.S.E. 112.08 ft. Set PK Nail & Tag in 15" Maple
 S.W. 94.20 ft. " " " " D.E. Pole
 N.W. 49.00 ft. " " " " 30" Locust
 N'ly 67.86 ft. to East 1/4 Cor. Sec. 13, T.6N., R.16E.

Signed by *Daniel E. Johnson*
 Daniel E. Johnson
 13754
 Surveyor's Michigan License No. _____

Date January 30, 1995

PA 345-1990
PEER COMMITTEE

APPROVED AS AN OFFICIAL GOVERNMENT CORNER BY ST. CLAIR COUNTY:

Signed By: *Daniel E. Johnson*
 St. Clair County Land Surveyor Daniel E. Johnson
 13754

7-31-95 Date

Surveyor's Michigan License No. _____

LIBER 008 PAGE 140